IREDELL COUNTY HEALTH DEPARTMENT

STATESVILLE 704-878-5305 MOORESVILLE 704-664-5281

IMPROVEMENT PERMIT / AUTHORIZATION TO CONSTRUCT / OPERATION PERMIT / EXISTING SYSTEM INSPECTION

PERMIT# REPAIR PIN# REPAIR DATE 3/21/00

OWNER OR CONTRACTOR BRYAN KALLZIJJ PHONE: Business Home

ADDRESS 149 PEAR TREE TROUTMAN

LOCATION OSWALT AMITY - TL PILCH - TL PEAR TREE RD - ON LT. # 149

SUBDIVISION - BLOCK / SECTION - LOT - LOT AREA - SITE CLASS PS DESIGN FLOW 360GPD L.T.A.R. EXISTING 2,4

Septic Tank: ~~EXISING 1000~~ Gallons; STB Date

Pump Tank: Gallons; PT Date

Pump Make: Model Serial No.

Nitrification Field: No Fields 1 Square Feet 225 Linear Feet 75 NEW

No Lines 1 Trench Width 36" Max Trench Bottom Depth 36" Gravel Depth 12"

☐ ~~New System~~ ☑ Repair System Type: I (II) III, IV, V, VI

System Description: GRAVITY CONVENTIONAL

Repair System Description:

Maintenance Agreement Required: ☐ Yes ☐ No

☐ ~~House/Mod. Home~~ No. Bedrooms 3

☐ Mobile Home No. Bathrooms 2

☐ Business No. Employees

☐ Other

☐ Slab ☐ Crawl Space ☐ Basement w/plumbing ☐ Basement wo/plumbing


Water Supply: ☐ ~~Individual~~ ☐ Public ☐ Community

Comments/Conditions: 1) CUT OFF 25 FEET OF EXISTING LINES. 2) AT 25', REMOVE EXISING LINES AND FILL AND TAMP IN NEW SOIL FOR EARTH DAM. 3) 10' OF EXISTING LINES SHALL BE REMOVED.


Comments/Conditions: 4) NEW 75 FOOT LINE SHALL BE ADDED TO MAKE UP FOR A 25 FOOT LOSS ON EXISING LINES.

(NO SCALE)

INITIAL SITE SKETCH

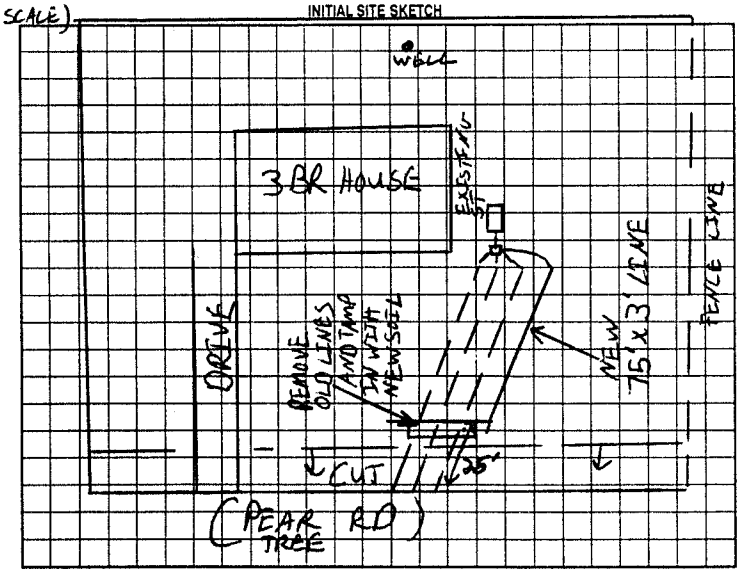

AS BUILT SKETCH

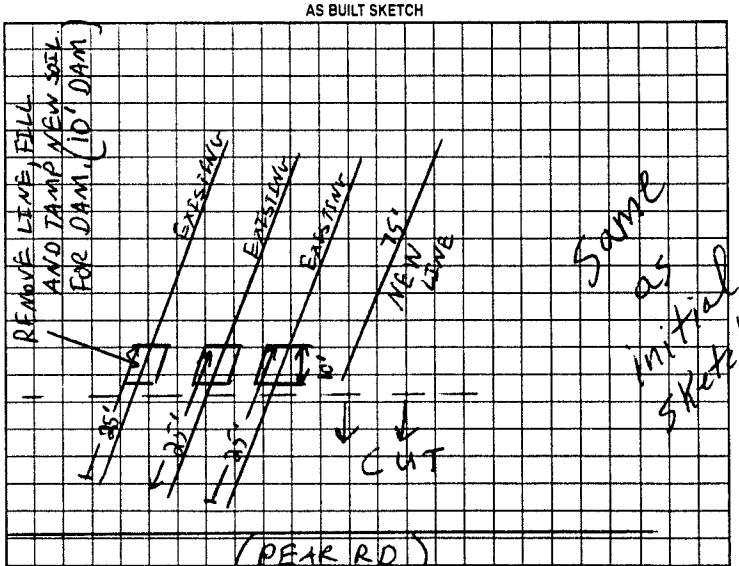

Same as initial sketch

Permit can be suspended or revoked if any false information is supplied toward securing the permit/any unauthorized changes are made to the site/any unauthorized changes are made in the installation of the system. Improvement Permit with plat valid without expiration. Improvement Permit with site plan valid for sixty months. Authorization to Construct is valid for a period equal to that of Improvement Permit – not to exceed sixty months.

Signed: Brent Gallihen date 4-4-00 Installed by: Brent Gallihen Grading

Improvement Permit by: C. [illegible] CS date 3/21/00 Operation Permit by: C. Moore date

Authorization to Construct by: date Existing System Inspection by: date

HEALTH DEPT. COPY: WHITE OWNER COPY (FINAL): YELLOW OWNER COPY (INITIAL): PINK