IREDELL COUNTY HEALTH DEPARTMENT

STATESVILLE 704-878-5305 MOORESVILLE 704-664-5281

IMPROVEMENT PERMIT / AUTHORIZATION TO CONSTRUCT / OPERATION PERMIT / EXISTING SYSTEM INSPECTION

I

agent
Called Bob Campbell 491-2289 @ 1:15

PERMIT# 42835 PIN# 4751164921 DATE 6-11-07

OWNER OR APPLICANT Richard Leath PHONE: Business Home 704-662-5523

ADDRESS 520 Williamson Road Suite A Mooresville NC

LOCATION Second Amity Rd to Pilot Rd to Peontown Rd to Grey Barn


SUBDIVISION Kelly Farms BLOCK / SECTION 3 LOT 36 LOT AREA 1.02 SITE CLASS IS DESIGN FLOW 360 L.T.A.R. .3

Septic Tank: 1000 Gallons; STB 1000 Date 10-15-07	☑ New System ☐ Repair ☐ Expansion System Type: I II III IV V VI	☑ House/Mod. Home	No. Bedrooms 3	Water Supply:
Pump Tank: Gallons; PT Date	System Description: 2520 Ground	☐ Mobile Home	No. Persons 2	☑ Individual
Pump Make: Model Serial No.	Repair System Description: 5070 Cap Rpl	☐ Business	No. Employees	☐ Public
Nitrification Field: No Fields Square Feet 1200 Linear Feet 300	Maintenance Agreement Required: ☐ Yes ☐ No	☐ Other		☐ Community
No Lines 3 Trench Width 36" Max Trench Bottom Depth 36"	Gravel Depth ☑ Gravity ☐ Pressure	☐ Slab ☐ Crawl Space ☐ Basement w/plumbing ☐ Basement wo/plumbing		


Comments:/Conditions:
Located on Contour
Maintain all setbacks

Comments:/Conditions: BOWCO Filter Manifold
System repair is 100' from any well
Builder showed me pl'd basements. All setbacks maintained

INITIAL SITE SKETCH

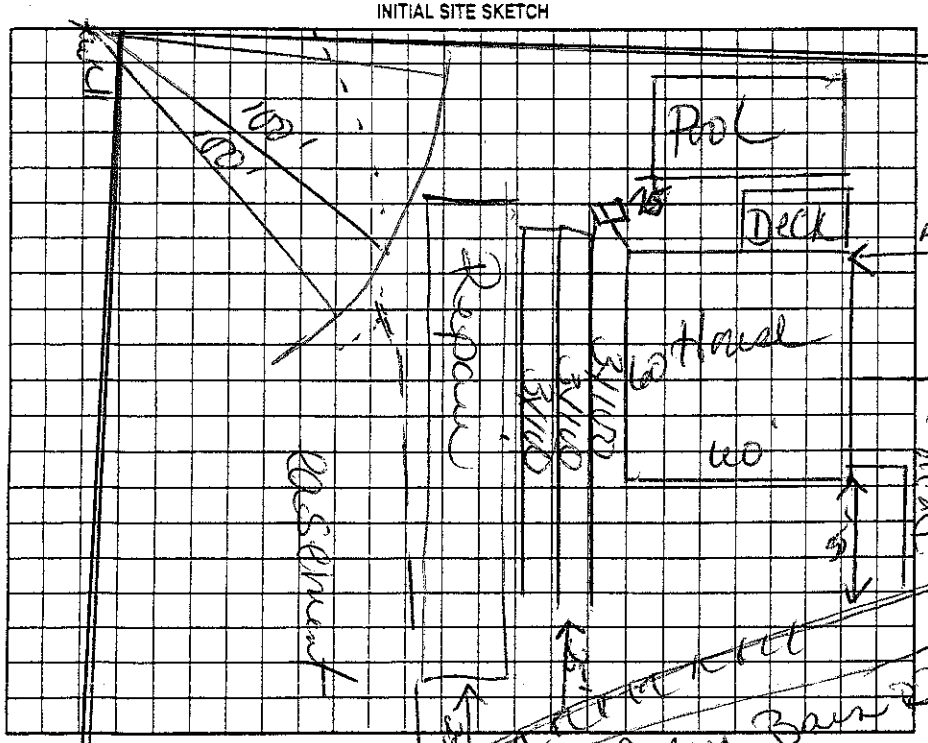

AS BUILT SKETCH

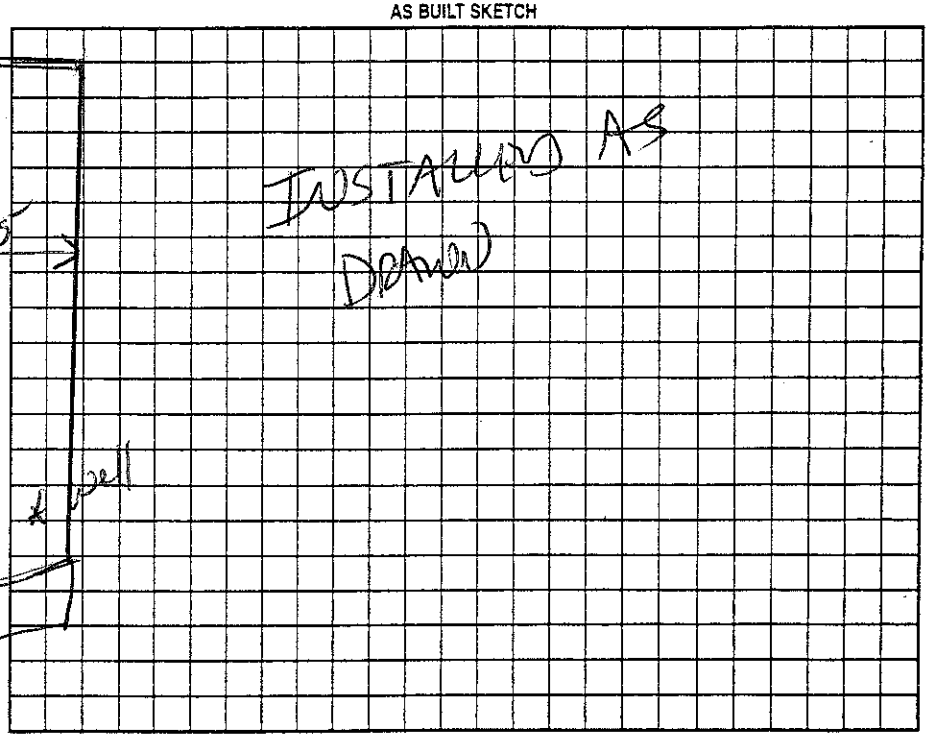

Permit can be suspended or revoked if any false information is supplied toward securing the permit/any unauthorized changes are made to the site/any unauthorized changes are made in the installation of the system. Improvement Permit with plat valid without expiration. ☐ Improvement Permit with site plan valid for sixty months ☐ Authorization to Construct is valid for a period equal to that of Improvement Permit – not to exceed sixty months.

Signed: date 6-28-07 Installed by: WAYNE CLONTZ

Improvement Permit by: date 6-11-07 Operation Permit by: date 12-6-07

Authorization to Construct by: date 6-11-07 Existing System Inspection by: date

HEALTH DEPT. COPY: WHITE OWNER COPY (FINAL): YELLOW OWNER COPY (INITIAL): PINK