IREDELL COUNTY HEALTH DEPARTMENT

STATESVILLE 704-878-5305 (C1) MOORESVILLE 704-664-5281

IMPROVEMENT PERMIT / AUTHORIZATION TO CONSTRUCT / OPERATION PERMIT / EXISTING SYSTEM INSPECTION

PERMIT# 094266 PIN# 4751 16 51 61 DATE 2/22/01

OWNER OR CONTRACTOR Harry Whitener PHONE: Business _____ Home (704) 528-4901

ADDRESS P.O. Box 4817 Troutman, NC 28166

LOCATION I-77 South, Exit # 45, (L) on Amity, (R) on Pilch Rd, @ Curve Straight on Peartree Rd 5th on left

SUBDIVISION Kelly BLOCK / SECTION — LOT 5 LOT AREA .59 Ac. SITE CLASS. PS DESIGN FLOW 360 L.T.A.R. .3

Septic Tank: 1000 Gallons; STB 794 Date 8-29-04
Pump Tank: _____ Gallons; PT _____ Date _____
Pump Make: _____ Model _____ Serial No. _____
Nitrification Field: No Fields 1 Square Feet 1200 equivalent to Linear Feet 300
No Lines 4 Trench Width 36" Max Trench Bottom Depth (30") Gravel Depth —

[X] New System [ ] Repair System Type: I, II, (III), IV, V, VI (Chambers)
System Description: 25% Reduction, HDPES Sections Gravity
Repair System Description: 50% Reduction, Pump
Maintenance Agreement Required: [ ] Yes [X] No


[X] House/Mod. Home No. Bedrooms 3
[ ] Mobile Home No. Bathrooms 2
[ ] Business No. Employees ____
[ ] Other _____

[ ] Slab [X] Crawl Space [ ] Basement w/plumbing [ ] Basement wo/plumbing

Water Supply: [X] Individual [ ] Public [ ] Community


Comments:/Conditions: (1) 25% Reduction System - Install 300 ft of HDPES Sections (2) Keep lines 10ft From property lines (3) Install lines on contour or Chambers with Contour Curves

INITIAL SITE SKETCH

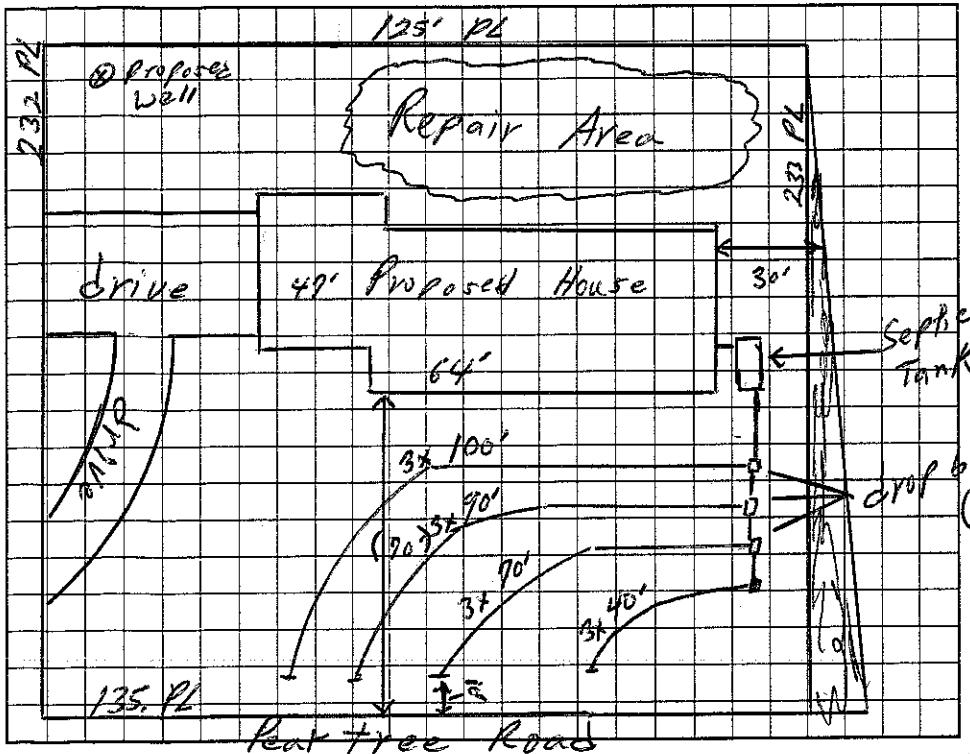

Comments:/Conditions: SEPTIC TANK WITH MARKER INSTALLED USING 4" RED POLYLOK" FILTER. SYSTEM INSTALLED AS SHOWN BELOW OUT OF CONTOUR ON LESS THAN 2% SLOPE USING

AS BUILT SKETCH

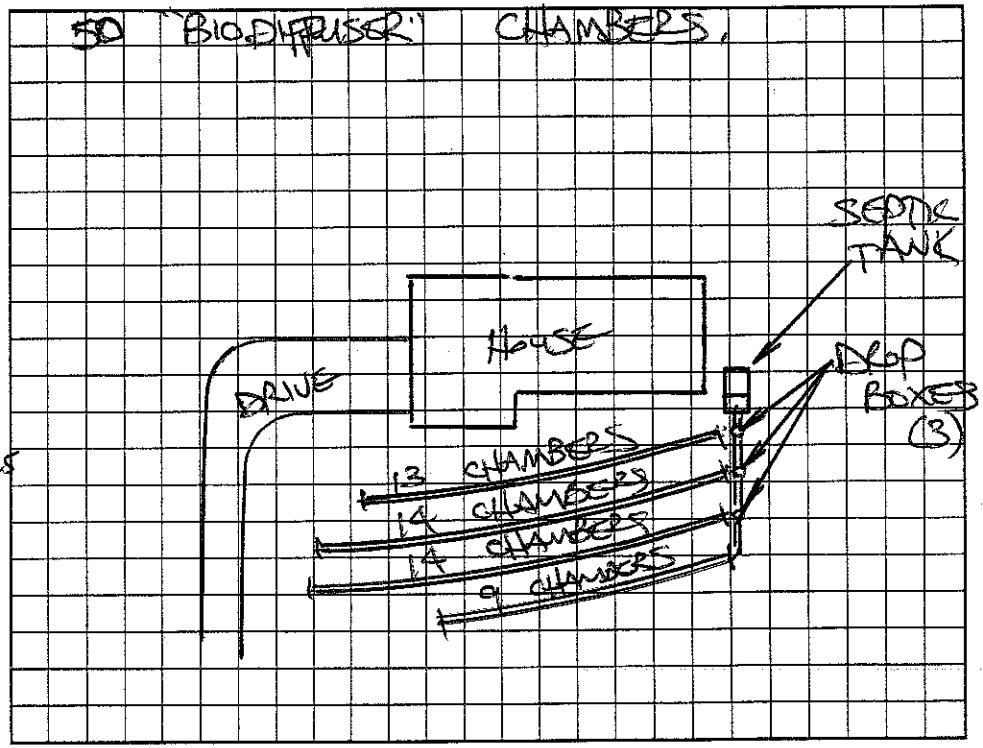

Permit can be suspended or revoked if any false information is supplied toward securing the permit/any unauthorized changes are made to the site/any unauthorized changes are made in the installation of the system. Improvement Permit with plat valid without expiration. Improvement Permit with site plan valid for sixty months. Authorization to Construct is valid for a period equal to that of Improvement Permit – not to exceed sixty months.

Signed: [signature] date 3/7-01 Installed by: ENVIRONMENTAL SERVICE (ROWAN COUNTY)

Improvement Permit by: William O. Johnson RSI date 2/22/01 Operation Permit by: STEVE HEDRICK date 10-12-04

Authorization to Construct by: William O. Johnson RSI date 2/22/01 Existing System Inspection by: _____ date _____

HEALTH DEPT. COPY: WHITE OWNER COPY (FINAL): YELLOW OWNER COPY (INITIAL): PINK