IREDELL COUNTY HEALTH DEPARTMENT

STATESVILLE 704-878-5305 MOORESVILLE 704-664-5281

IMPROVEMENT PERMIT / CERTIFICATE OF COMPLETION / OPERATION PERMIT / EXISTING SYSTEM INSPECTION

PROPERTY DESCRIPTION NO. 68068 DATE 7-22-97 TAX MAP NO. 4751166409 Watershed: ☐ Yes ☐ No

OWNER OR CONTRACTOR Keith Kelly PHONE: Business _____ Home 528/5306

ADDRESS 112 Nutmeg Lane Troutman N.C.

LOCATION Amity Hill RD TR Pilch TR Gray Barn Corner Pear Tree

SUBDIVISION Kelly's Farmstead BLOCK / SECTION _____ LOT 1 LOT AREA 1 Macre SITE CLASS. PS DESIGN FLOW 360 L.T.A.R. 1.3

Septic Tank: 1000 Gallons; STB 794 Date 2-24-98
Pump Tank: _____ Gallons; PT _____ Date _____
Pump Make: _____ Model _____ Serial No. _____
Nitrification Field: No Fields 1 Square Feet 1200 Linear Feet 400
No Lines 3 Trench Width 36 Max Trench Bottom Depth 36 Gravel Depth 12"

☑ New System ☐ Repair System Type: I, II, III, IV, V, VI
System Description: Conv. Gravity
Repair System Description: "
Maintenance Agreement Required: ☐ Yes ☑ No

☑ House/Mod. Home No. Bedrooms 3
☐ Mobile Home No. Bathrooms 2
☐ Business No. Employees _____
☐ Other _____


☐ Slab ☑ Crawl Space ☐ Basement w/plumbing ☐ Basement wo/plumbing

Water Supply:
☑ Individual
☐ Community
☐ Public


Comments:

Comments:

INITIAL SITE SKETCH 225'

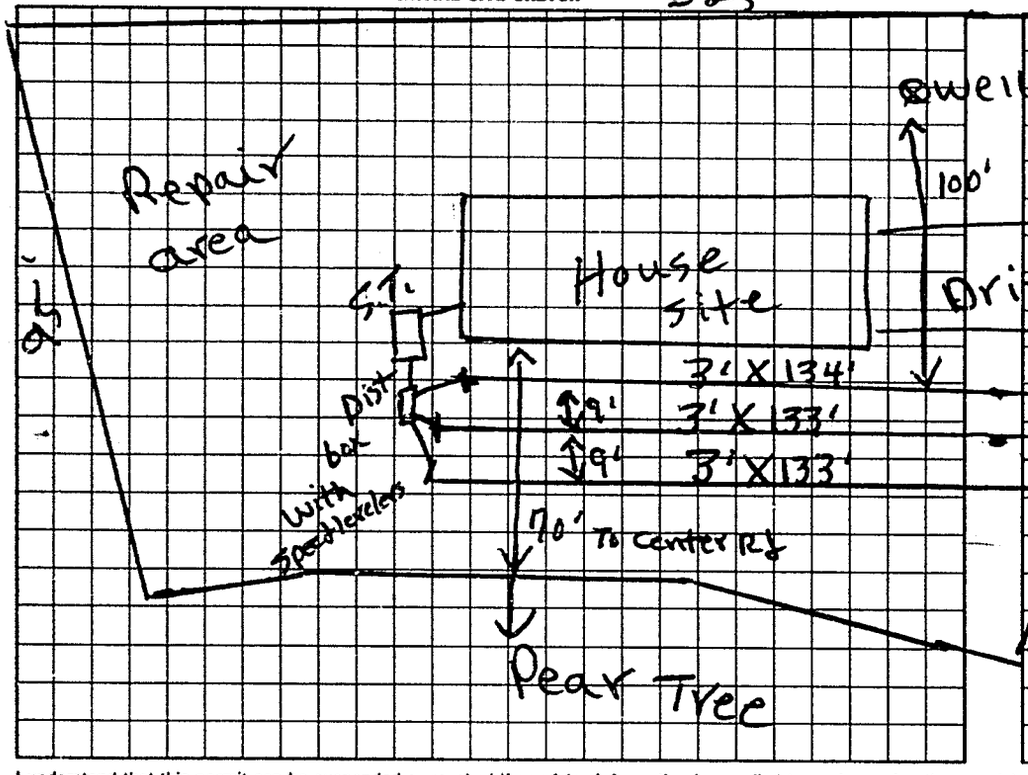

AS BUILT SKETCH

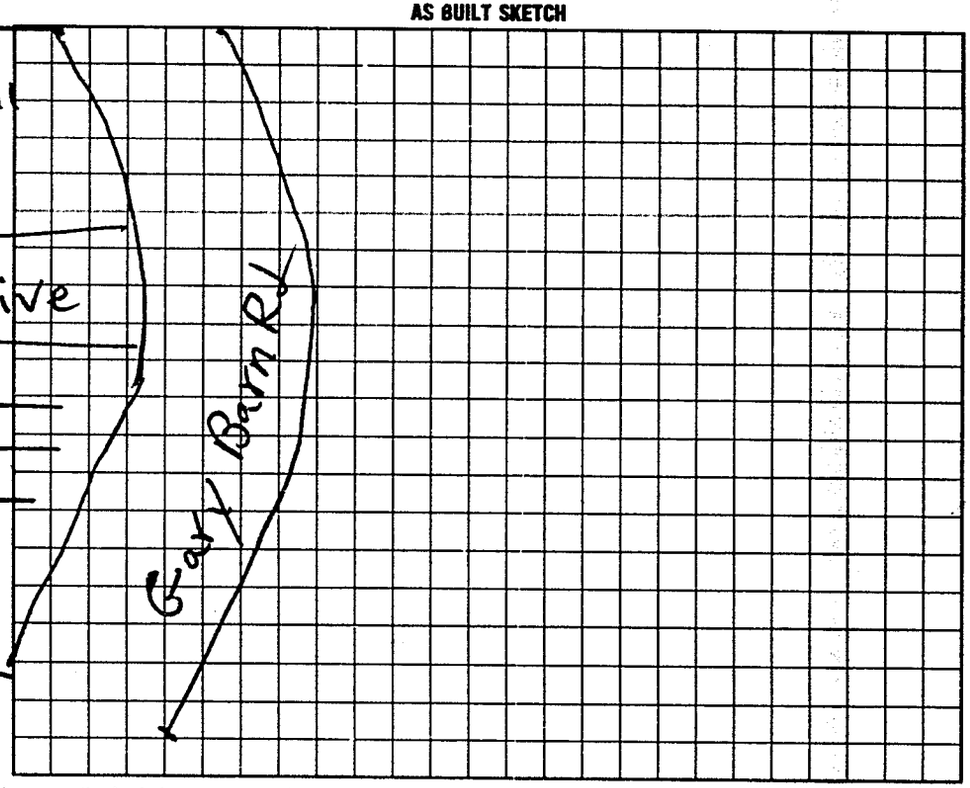

I understand that this permit can be suspended or revoked if any false information is supplied toward securing the permit/any unauthorized changes are made to the site/any unauthorized changes are made in the installation of the system. Improvement Permit is valid for 60 months from date of issuance.

Signed: X W. Keith Kelly

Improvement Permit by: R. C. Moore date 7-22-97

Authorization to Existing System Inspection by: R. C. Moore date 7-22-97

Installed by: Wes Eytton

Certificate of Completion by: _____ date _____

Operation Permit by: R. C. Moore date 3-30-98

HEALTH DEPT. COPY: WHITE INSPECTION COPY (FINAL): GREEN OWNER COPY (FINAL): YELLOW INSPECTION COPY (INITIAL): PINK OWNER COPY (INITIAL): GOLD

To Count. Authorization to Count EXPIRES 60 mos From Issue

8 1 5 2 0 0