IREDELL COUNTY HEALTH DEPARTMENT

STATESVILLE 704-878-5305 CF MOORESVILLE 704-664-5281

IMPROVEMENT PERMIT / AUTHORIZATION TO CONSTRUCT / OPERATION PERMIT / EXISTING SYSTEM INSPECTION

PERMIT# 132 056 PIN# 4751166634 DATE 11-23-05

OWNER OR CONTRACTOR GENE SHELLEY PHONE: Business 704-258-3648 Home

ADDRESS 116 CROSS BOW LANE MOORESVILLE, NC 28117

LOCATION 77S @ AMITY HILL @ PILOT STAY STRAIGHT ON PENROSE @ BARN RED ON LOT ON LEFT

SUBDIVISION Kelly HOMESTEAD BLOCK / SECTION II LOT 13 LOT AREA 1.847 SITE CLASS PS DESIGN FLOW 360 L.T.A.R. 13

Septic Tank: 1000 Gallons; STB 794 Date 4-11-06
Pump Tank: 1000 Gallons; PT 268 Date 5-24-06
Pump Make: ZOELLER Model N-152A Serial No.
Nitrification Field: No Fields 1 Square Feet EQ=1100' Linear Feet 300'
No Lines 4X75 Trench Width 36" Max Trench Bottom Depth 36" Gravel Depth N/A

☒ New System ☐ Repair System Type: I, II, III, IV, V, VI.
System Description: PUMP 25% REDUCT
Repair System Description: LP 50% REDUCT
Maintenance Agreement Required: ☐ Yes ☒ No

☒ House/Mod. Home No. Bedrooms 3
☐ Mobile Home No. Bathrooms 2
☐ Business No. Employees
☐ Other


☐ Slab ☒ Crawl Space ☐ Basement w/plumbing ☐ Basement wo/plumbing

Water Supply: ☒ Individual ☐ Public ☐ Community


Comments:/Conditions: ① INSTALL LINES ON CONTOURS & MAINTAIN SETBACKS. ② SAPROLITE SYSTEM. STAY 100' FROM WELLS WITH SEPTIC, STAY 50' + FROM SUPPLY LINES & WELLS.

Comments:/Conditions: ③ CALL PRIOR TO INSTALLATION FOR SYSTEM SETS IF NECESSARY
RED POLY LOC Filter & MANIFOLD

1"=50' INITIAL SITE SKETCH

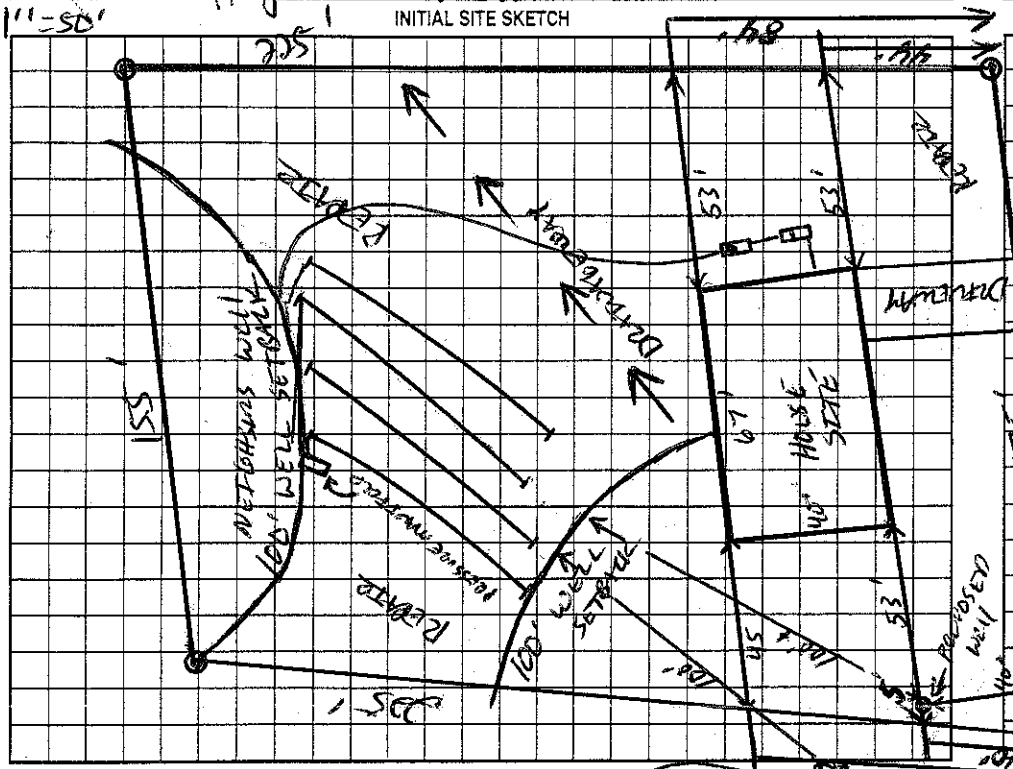

AS BUILT SKETCH

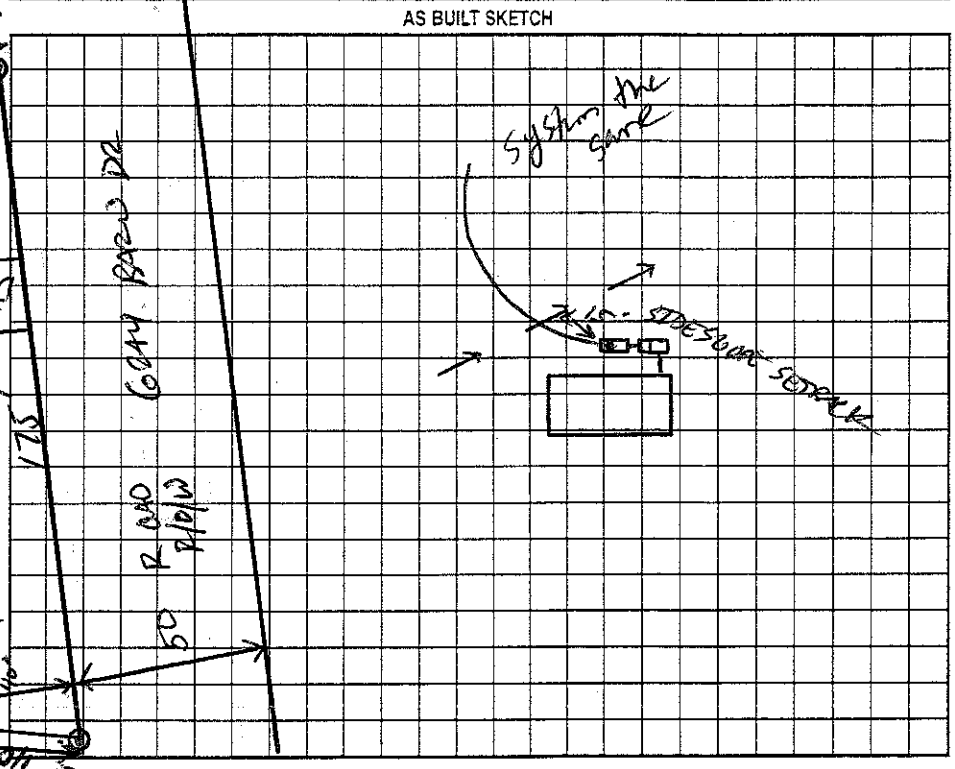

Permit can be suspended or revoked if any false information is supplied toward securing the permit/any unauthorized changes are made to the site/any unauthorized changes are made in the installation of the system. Improvement Permit with plat valid without expiration. Improvement Permit with site plan valid for six months. Authorization to Construct is valid for a period equal to that of Improvement Permit – not to exceed sixty months.

Signed: X C. Shelley date Installed by: LARRY BEAM

Improvement Permit by: date 11-23-05 Operation Permit by: date 7-28-06

Authorization to Construct by: date 11-23-05 Existing System Inspection by: date

HEALTH DEPT. COPY: WHITE OWNER COPY (FINAL): YELLOW OWNER COPY (INITIAL): PINK