53828

IREDELL COUNTY HEALTH DEPARTMENT

STATESVILLE 704-878-5305 MOORESVILLE 704-664-5281

IMPROVEMENT PERMIT / CERTIFICATE OF COMPLETION / OPERATION PERMIT / EXISTING SYSTEM INSPECTION

PROPERTY DESCRIPTION NO. 19902 DATE 12-14-94 TAX MAP NO. 46-B-59 Watershed: ☐ Yes ☑ No

OWNER OR CONTRACTOR William Scott Feimster PHONE: Business _____ Home 873-2015

ADDRESS 712 Murdock Rd Troutman 28166

LOCATION I-77 S Tl Amity Hill Rd TR Pickard Town Rear Tree 1st Hse Rt.

SUBDIVISION Kelly Properties BLOCK / SECTION _____ LOT _____ LOT AREA 1 acre SITE CLASS. PS DESIGN FLOW 360 L.T.A.R. .35

Septic Tank: 1000 Gallons; STB 794 Date 2-14-95

Pump Tank: _____ Gallons; PT _____ Date _____

Pump Make: _____ Model _____ Serial No. _____

Nitrification Field: No Fields 1 Square Feet 1075 Linear Feet 345

No Lines 4 Trench Width 36" Max Trench Bottom Depth 36" Gravel Depth 12"

☑ New System ☐ Repair System Type: I, II, III, IV, V, VI

System Description: Conv. Gravity

Repair System Description: " "

Maintenance Agreement Required: ☐ Yes ☑ No

☑ House/Mod. Home No. Bedrooms 3

☐ Mobile Home No. Bathrooms 2

☐ Business No. Employees _____

☐ Other _____

☐ Slab ☑ Crawl Space ☐ Basement w/plumbing ☐ Basement wo/plumbing


Water Supply: ☑ Individual ☐ Community ☐ Public

Comments:

Keep well 100' from S.T. System or Repair area

Comments:

INITIAL SITE SKETCH

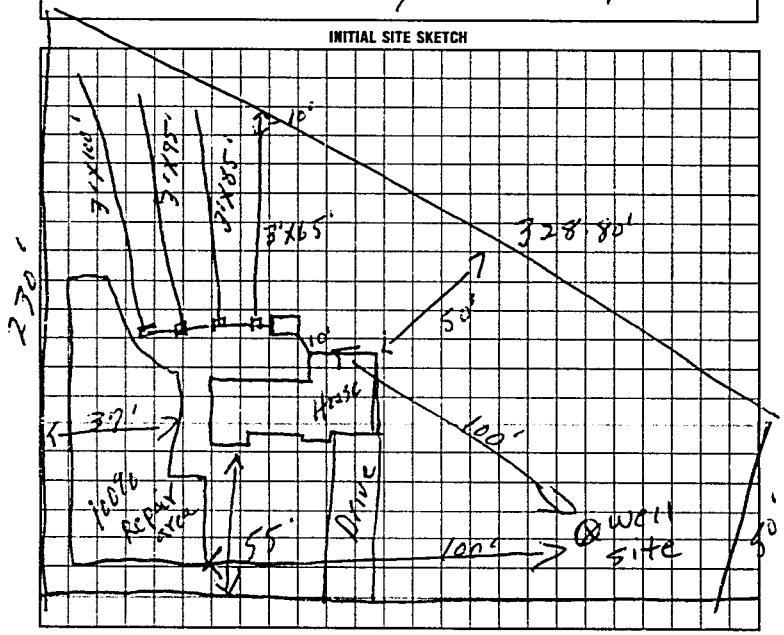

AS BUILT SKETCH

Same as initial sketch

I understand that this permit can be suspended or revoked if any false information is supplied toward securing the permit/any unauthorized changes are made to the site/any unauthorized changes are made in the installation of the system. Improvement Permit is valid for 60 months from date of issuance.

Signed: X William Scott Feimster

Improvement Permit by: R. C. Moore date 12-14-94

Existing System Inspection by: _____ date _____

Installed by: Wes Fytton

Certificate of Completion by: R. C. Moore date 5-3-95

Operation Permit by: _____ date _____

HEALTH DEPT. COPY WHITE INSPECTION COPY (FINAL) GREEN OWNER COPY (FINAL) YELLOW INSPECTION COPY (INITIAL) PINK OWNER COPY (INITIAL) GOLD

5 2 2 0 0 0