IREDELL COUNTY HEALTH DEPARTMENT

STATESVILLE 704-878-5305 MOORESVILLE 704-664-5281

IMPROVEMENT PERMIT / AUTHORIZATION TO CONSTRUCT / OPERATION PERMIT / EXISTING SYSTEM INSPECTION

PERMIT# 74396 PIN# 4751 16 8473 DATE 6-11-98

OWNER OR CONTRACTOR Tim whitner PHONE: Business 528 4901 Home

ADDRESS 112 Nutmeg Ln Troutman, N.C.

LOCATION Amity Hill TR Pilch TR, Pear Tree TR Grain Barn on rt.

SUBDIVISION Kelly Farm Street BLOCK / SECTION LOT 4 LOT AREA .81 SITE CLASS PS DESIGN FLOW 480 L.T.A.R. .33

Septic Tank: 1000 Gallons; STB 794 Date 3-1-99
Pump Tank: Gallons; PT Date
Pump Make: Model Serial No.
Nitrification Field: No Fields 1 Square Feet 1440 Linear Feet 480
No Lines 6 Trench Width 36" Max Trench Bottom Depth 36" Gravel Depth 12"

☑ New System ☐ Repair System Type: I, II, III, IV, V, VI
System Description: Conv. Gravity
Repair System Description: Pump to chambers
Maintenance Agreement Required: ☐ Yes ☐ No


☑ House/Mod. Home No. Bedrooms 4
☐ Mobile Home No. Bathrooms 2
☐ Business No. Employees
☐ Other
☐ Slab ☑ Crawl Space ☐ Basement w/plumbing ☐ Basement wo/plumbing

Water Supply: ☑ Individual ☐ Public ☐ Community

Comments:/Conditions:

2 dist boxes with speed levelers

INITIAL SITE SKETCH

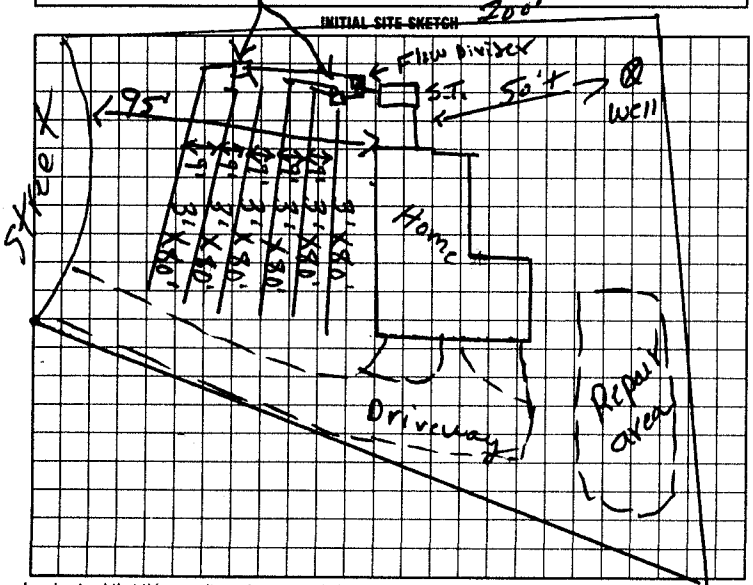

Comments:/Conditions:

AS BUILT SKETCH

Same as initial sketch

I understand that this permit can be suspended or revoked if any false information is supplied toward securing the permit/any unauthorized changes are made to the site/any unauthorized changes are made in the installation of the system. Improvement Permit with plat valid without expiration. Improvement Permit with site plan valid for sixty months. Authorization to Construct is valid for a period equal to that of Improvement Permit – not to exceed sixty months.

Signed: W. Kyle Talley date

Improvement Permit by: D.C. Moore date 6-11-98

Authorization to Construct by: D.C. Moore date 6-11-98

Installed by: Wes Lytton

Operation Permit by: D.C. Moore date 5-28-99

Existing System Inspection by: date

HEALTH DEPT. COPY: WHITE INSPECTION COPY (FINAL): GREEN OWNER COPY (FINAL): YELLOW INSPECTION COPY (INITIAL): PINK OWNER COPY (INITIAL): GOLD