60110

IREDELL COUNTY HEALTH DEPARTMENT

STATESVILLE 704-878-5305 MOORESVILLE 704-664-5281

IMPROVEMENT PERMIT / CERTIFICATE OF COMPLETION / OPERATION PERMIT / EXISTING SYSTEM INSPECTION

PROPERTY DESCRIPTION NO 23401 DATE 3-22-96 TAX MAP NO 46-B - Pt 59 Watershed: Yes (No)

OWNER OR CONTRACTOR Kelly Const. PHONE Business Home 528 4901

ADDRESS 167 Perthwood Dr. Troutman

LOCATION I-77 S TL Amity Hill TR Pilch TR Pear Tree TR Gray Barn 1000' Pt

SUBDIVISION Kelly Farmstead BLOCK / SECTION LOT 5 LOT AREA 1.692 acres SITE CLASS PS DESIGN FLOW 360 L.T.A.R 1.3

Septic Tank 1000 Gallons; STB 794 Date 5-8-96
Pump Tank Gallons; PT Date
Pump Make Model Serial No
Nitrification Field No Fields 1 Square Feet 1200 Linear Feet 400
No Lines 4 Trench Width 36" Max Trench Bottom Depth 36" Gravel Depth 12"

(New System) Repair System Type I II III IV V VI
System Description: Conv. Gravity
Repair System Description: Gravity Chambers
Maintenance Agreement Required Yes No


(House/Mod. Home) No Bedrooms 3
Mobile Home No Bathrooms 2
Business No Employees
Other
Slab Crawl Space Basement w/plumbing Basement w/o plumbing

Water Supply: (Individual) Community Public


Comments

Comments

INITIAL SITE SKETCH

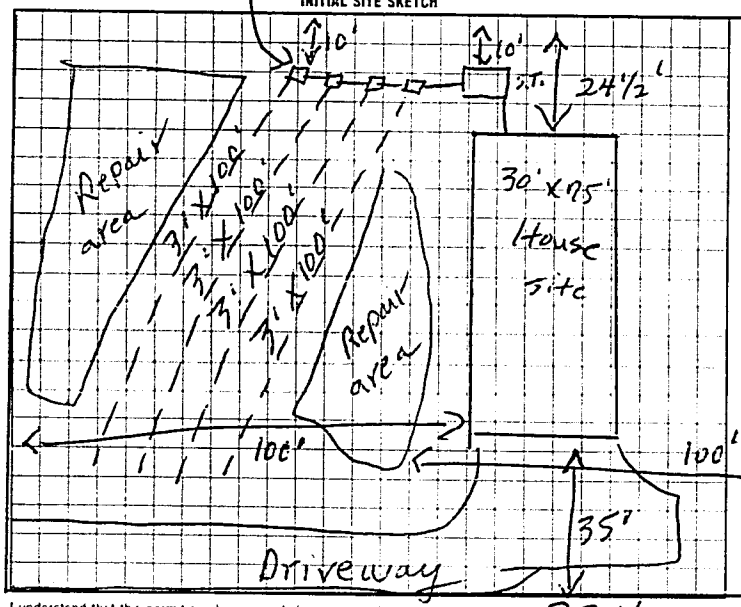

AS BUILT SKETCH

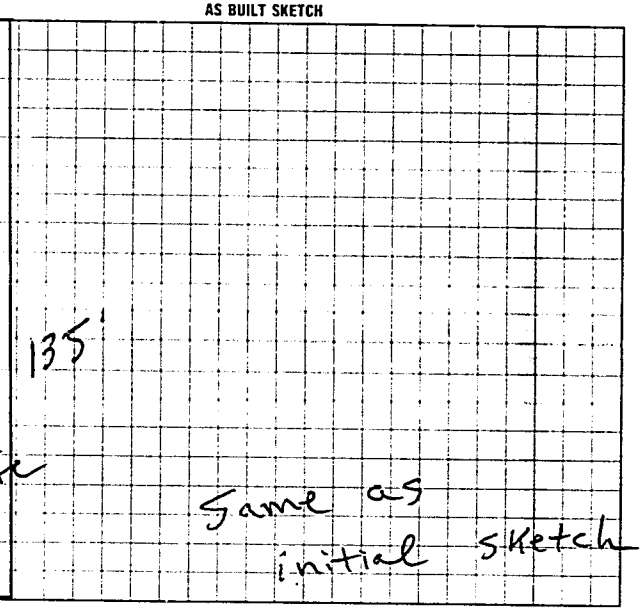

I understand that this permit can be suspended or revoked if any false information is supplied in securing the permit, any unauthorized changes are made to the site/any unauthorized changes are made in the installation of the system

Signed X Greg Kelly

Improvement Permit by Authorization to Construct F. C. Moore date 3-22-96

Certificate of Completion by F. C. Moore date 3-22-96

Operation Permit by F. C. Moore date 7-19-96

Installed by Wes Lytton

Authorization to Construct Expires 60 mos from issue