IREDELL COUNTY HEALTH DEPARTMENT

STATESVILLE 704-878-5305 — MOORESVILLE 704-664-5281

IMPROVEMENT PERMIT / CERTIFICATE OF COMPLETION / OPERATION PERMIT / EXISTING SYSTEM INSPECTION

3:00

PROPERTY DESCRIPTION NO 23402 DATE 3-22-96 TAX MAP NO 4L -B- Pt 59 Watershed: Yes ~~No~~

OWNER OR CONTRACTOR Kelly Const. PHONE Business Home 528-4901

ADDRESS 164 Perthwood Dr. Troutman

LOCATION I-77 S TL Amity Hill TR Filch Turn Pear Tree Gray Barn Dr. 1000' Rt

SUBDIVISION Kelly Farmstead BLOCK / SECTION LOT 6 LOT AREA 1.652 acres SITE CLASS PS DESIGN FLOW 360 L.T.A.R. 13

Septic Tank 1000 Gallons STB 794 Date 2-3-97

Pump Tank Gallons PT Date

Pump Make Model Serial No

Nitrification Field No Fields 1 Square Feet 1200 Linear Feet 400

No Lines 84 Trench Width 36" Max Trench Bottom Depth 36" Gravel Depth 12"

~~New System~~ Repair System Type I II III IV V VI

System Description Conv. Gravity

Repair System Description " "

Maintenance Agreement Required Yes ~~No~~

~~House/Mod~~ Home No Bedrooms 3

Mobile Home No Bathrooms 2

Business No Employees

Other


Slab ~~Crawl Space~~ Basement w/plumbing Basement wo/plumbing

Water Supply: ~~Individual~~ Community Public


Comments

Comments

INITIAL SITE SKETCH

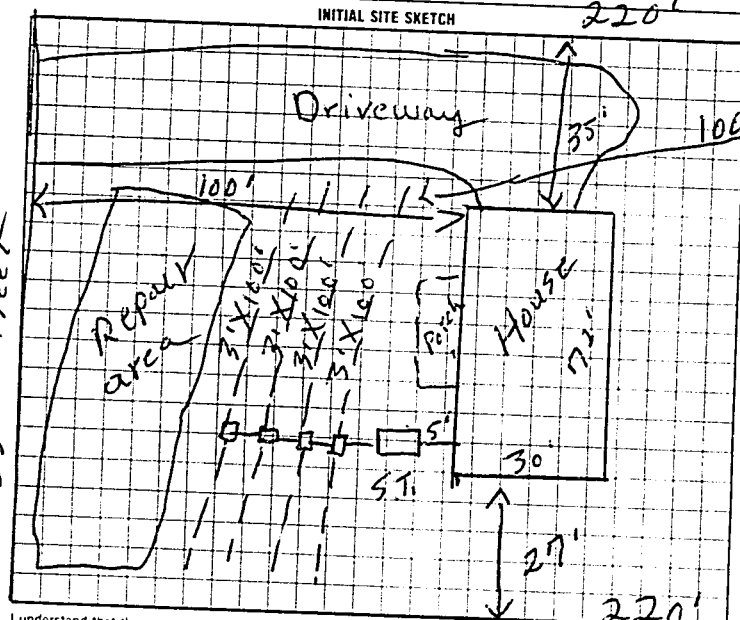

AS BUILT SKETCH

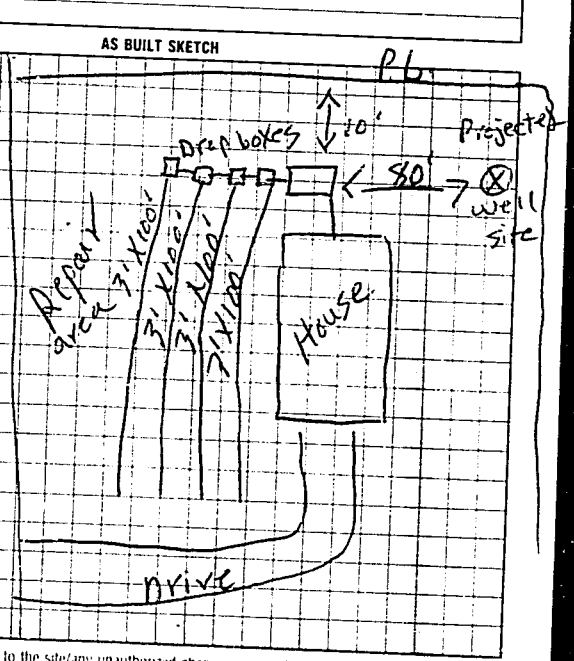

I understand that this permit can be suspended or revoked if any false information is supplied toward securing the permit any unauthorized changes are made to the site/any unauthorized changes are made in the installation of the system

Signed

Improvement Permit by authorization to cont. L.C. Moore date 3-22-96

Installed by Wes Fytton

Certificate of Completion by L.C. Moore date 3-22-96

Operation Permit by L.C. Moore date 3-1-97

Authorization to cont. Expires 60 mos from issue

