IREDELL COUNTY HEALTH DEPARTMENT

STATESVILLE 704-878-5305 MOORESVILLE 704-664-5281

IMPROVEMENT PERMIT / AUTHORIZATION TO CONSTRUCT / OPERATION PERMIT / EXISTING SYSTEM INSPECTION

PERMIT# 70789 PIN# 4751169918 DATE 12-16-97

OWNER OR CONTRACTOR Mike Gagnier PHONE: Business Home 528 4901

ADDRESS 134 Gray Barn Rd

LOCATION Amity Hill TR Pilch TR Bear Tree TR Gray Barn 1/8 mi Rt

SUBDIVISION Kelly Farmstead BLOCK / SECTION LOT 8 LOT AREA .179 acres SITE CLASS. P5 DESIGN FLOW 360 L.T.A.R. .133

Septic Tank: 1000 Gallons; STB .794 Date 5-28-96

Pump Tank: Gallons; PT Date

Pump Make: Model Serial No.

Nitrification Field: No Fields 1 Square Feet 1080 Linear Feet 360

No Lines 3 Trench Width 36" Max Trench Bottom Depth 36" Gravel Depth 12"

☑ New System ☐ Repair System Type: I, II, III, IV, V, VI

System Description: Conv. Gravity

Repair System Description: LPP Panels

Maintenance Agreement Required: ☐ Yes ☐ No

☑ House/Mod. Home No. Bedrooms 3

☐ Mobile Home No. Bathrooms 2

☐ Business No. Employees

☐ Other

☐ Slab ☐ Crawl Space ☑ Basement w/plumbing ☐ Basement wo/plumbing

Water Supply: ☑ Individual ☐ Public ☐ Community


Comments:/Conditions:

100' Driveway width


Comments:/Conditions:

203' Dist. boxes

INITIAL SITE SKETCH

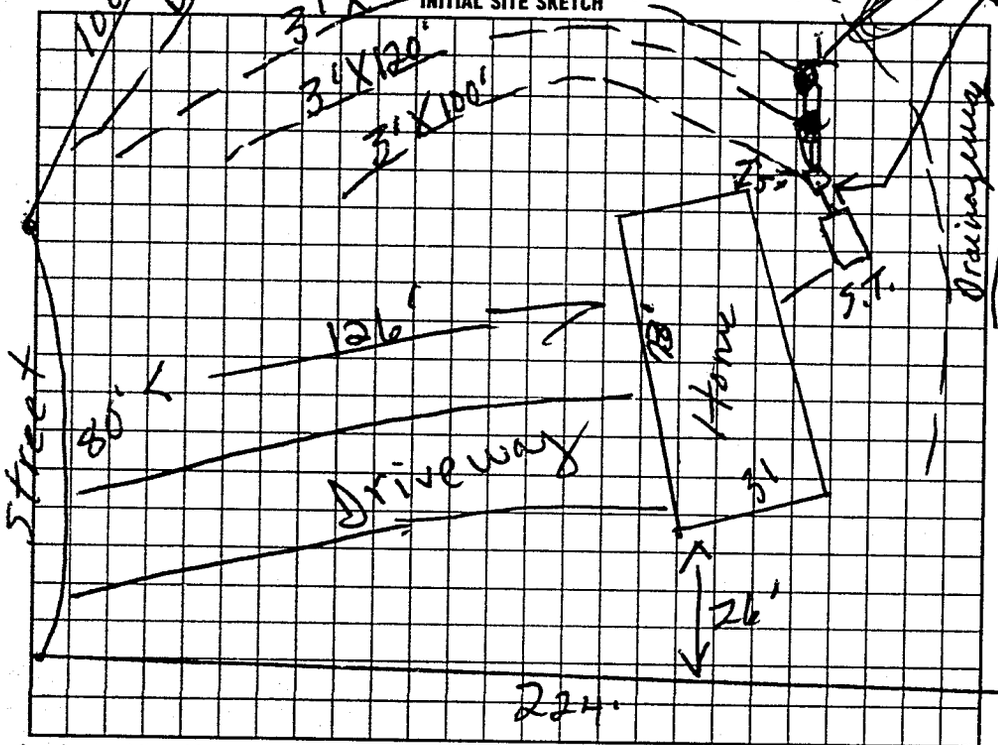

AS BUILT SKETCH

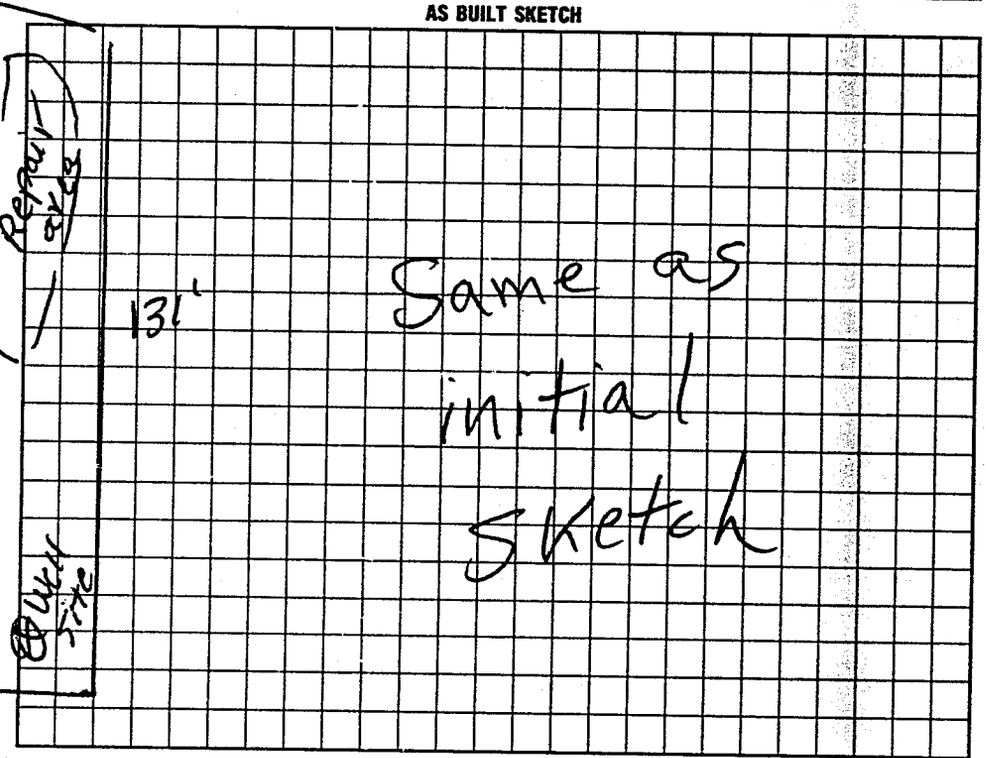

I understand that this permit can be suspended or revoked if any false information is supplied toward securing the permit/any unauthorized changes are made to the site/any unauthorized changes are made in the installation of the system. Improvement Permit with plat valid without expiration. Improvement Permit with site plan valid for sixty months. Authorization to Construct is valid for a period equal to that of Improvement Permit – not to exceed sixty months.

Signed: X W. Dirk Dale date

Improvement Permit by: P.C. Moore date 12-16-97

Authorization to Construct by: P.C. Moore date 12-16-97

Installed by: Wes Lytton

Operation Permit by: P.C. Moore date 9-14-98

Existing System Inspection by: date

HEALTH DEPT COPY: WHITE INSPECTION COPY (FINAL): GREEN OWNER COPY (FINAL): YELLOW INSPECTION COPY (INITIAL): PINK OWNER COPY (INITIAL): GOLD