IREDELL COUNTY HEALTH DEPARTMENT

This permit voids previously issued permit dated 7/16/01. CI

STATESVILLE 704-878-5305 MOORESVILLE 704-664-5281

IMPROVEMENT PERMIT / AUTHORIZATION TO CONSTRUCT / OPERATION PERMIT / EXISTING SYSTEM INSPECTION

PERMIT# 101257 PIN# 4751-17-2352 DATE 8/11/03

OWNER OR CONTRACTOR Virginia Ward / Penny Tompkins PHONE: Business _____ Home _____

ADDRESS ~~[illegible]~~ 114 Cary Barn Drive Troutman, NC 28166

LOCATION 115 N DR Brandt Smith, TL Pitch Rd, TL Deer Tree, TR Cary Barn Drive, Lot 11 on Right

SUBDIVISION Kelly Farmsteads BLOCK / SECTION 3 LOT 24 LOT AREA ± 40,000 ft² SITE CLASS. P5 DESIGN FLOW 480 L.T.A.R. .30

Septic Tank: 4000 Gallons; STB 1012 Date 7-12-03
Pump Tank: _____ Gallons; PT _____ Date _____
Pump Make: _____ Model _____ Serial No. _____
Nitrification Field: No Fields ___ Square Feet Eq/800 Linear Feet 270
No Lines 6 Trench Width 24" Max Trench Bottom Depth 36" Gravel Depth 6" Sand

☒ New System ☐ Repair System Type: I, II, (III), IV, V, VI
System Description: Gravity, 50% Reduction
Repair System Description: Gravity, Pump LP
Maintenance Agreement Required: ☐ Yes ☒ No

☒ House/Mod. Home ☐ Mobile Home ☐ Business ☐ Other
No. Bedrooms 4 No. Bathrooms 4 No. Employees ___


Water Supply: ☒ Individual ☐ Public ☐ Community

☐ Slab ☐ Crawl Space ☒ Basement w/plumbing ☐ Basement wo/plumbing

Comments:/Conditions: ① Install 62 PPBP sections with one flow distributor two (2) distribution boxes. ② Install surface drainage as shown

Comments:/Conditions: Inst Cure Okay - 9/11/03
(bottom line installed over low area)

INITIAL SITE SKETCH

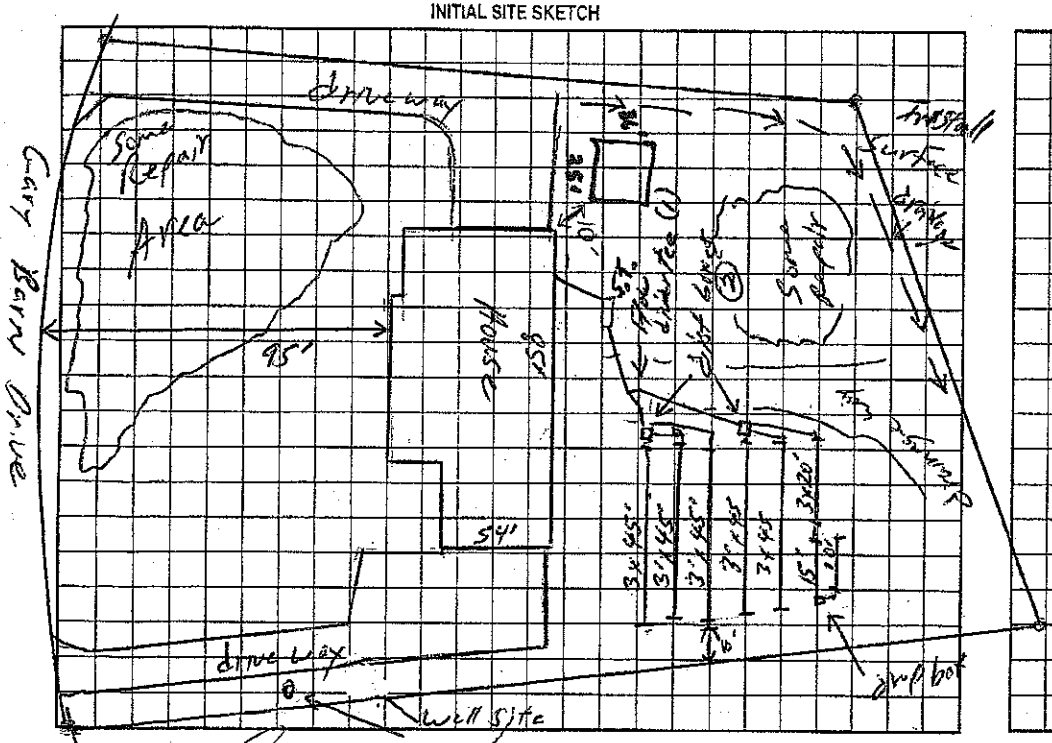


AS BUILT SKETCH

Location of the proposed 25'x36' DETACHED GARAGE addition does not appear to impact the existing on-site septic system.**NOTE: KEEP MINIMUM 5' FROM SYSTEM

R. STEVE HEDRICK REHS

Date: JANUARY 30, 2012

ICHD-Environmental Health Division

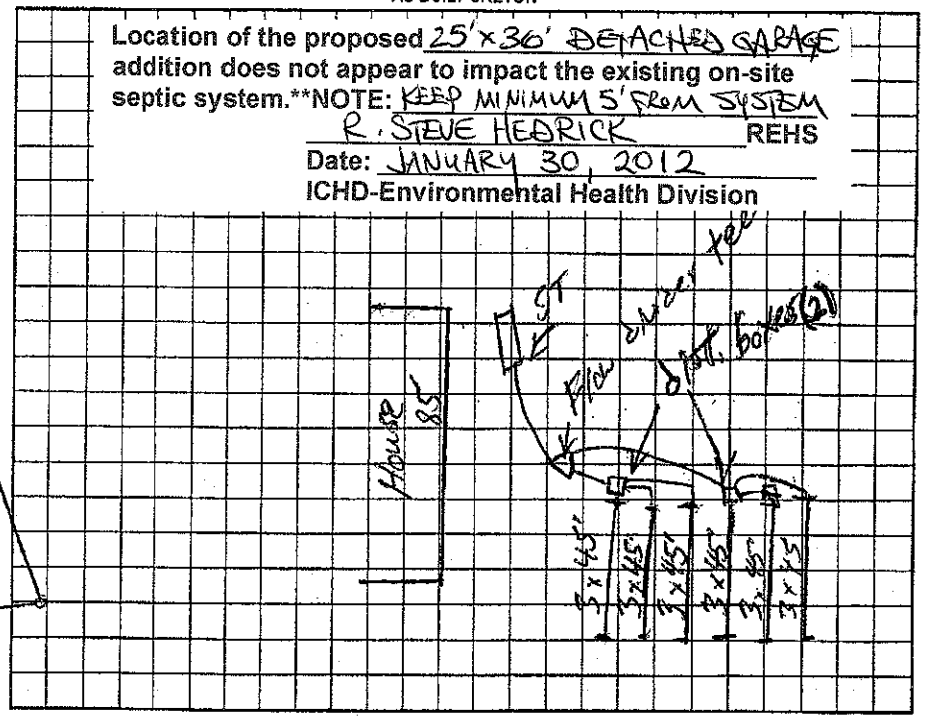

Permit can be suspended or revoked if any false information is supplied toward securing the permit/any unauthorized changes are made to the site/any unauthorized changes are made in the installation of the system. Improvement Permit with plat valid without expiration. Improvement Permit with site plan valid for sixty months. Authorization to Construct is valid for a period equal to that of Improvement Permit – not to exceed sixty months.

Signed: _____ date _____

Improvement Permit by: William O. Johnson date 8/11/03

Authorization to Construct by: William O. Johnson date 9/11/03

Installed by: Craig Thompson

Operation Permit by: William O. Johnson date 9/12/03

Existing System Inspection by: _____ date _____

HEALTH DEPT. COPY: WHITE OWNER COPY (FINAL): YELLOW OWNER COPY (INITIAL): PINK