IREDELL COUNTY HEALTH DEPARTMENT ***ENVIRONMENTAL HEALTH*** ☐ STATESVILLE OFFICE 704-878-5305 ☐ MOORESVILLE OFFICE 704-664-5281

IMPROVEMENT PERMIT / AUTHORIZATION TO CONSTRUCT / OPERATION PERMIT / EXISTING SYSTEM INSPECTION

PERMIT # 171678 PIN # 4951-17-2720 DATE APR. 24 2012

OWNER JULIANNE S. HULMS APPLICANT: SAME PHONE: Home/Cell # 704 483-7930 Business # 552 200 1952

SITE ADDRESS 116 TREESIDE COURT OWNER / APPLICANT ADDRESS

SITE DIRECTIONS PILCH ROAD TO PEACH TREE ROAD, TR FIELDS HAVEN PLACE TREE SIDE COURT, LOT AT END OF CUL DE SAC

SUBDIVISION KELLY FARMSTEADS BLOCK / SECTION P3 S2 LOT # 31 LOT AREA 0.85 ACRE DESIGN FLOW 360 L.T.A.R. 0.25 GPD/FT²

Septic Tank 1000 Gallons: STB ____ Date ____

Pump Tank ____ Gallons: P T ____ Date ____

Pump Make ____ Model ____ Serial # ____

No. Nitrification Fields: 1 No. Lines 5 Linear Feet 360

Trench Width 36" Max. Trench Bottom Depth 36

☑ New System ☐ Repair ☐ Expansion System Type I II III IV V VI

System Description: 25% REDUCTION, GRAVITY

Repair System Description: 50% REDUCTION, LOW PRESS

Maintenance Agreement Required ☐ YES ☑ NO

Gravel Depth NA ☑ GRAVITY ☐ PRESSURE

☑ Residence No. Bedrooms 3

☐ Business No. Persons ____

☐ Other No. Employees ____


☐ Slab ☐ Crawl Space

☑ Basement w/plumbing ☐ Basement w/o plumbing


Water Supply: ☑ Private WELL ☐ Public ☐ Community

Comments / Conditions INSTALL 25% REDUCTION SYSTEM ON CONTOUR AS SHOWN USING SERIAL DISTRIBUTION

INITIAL SITE SKETCH

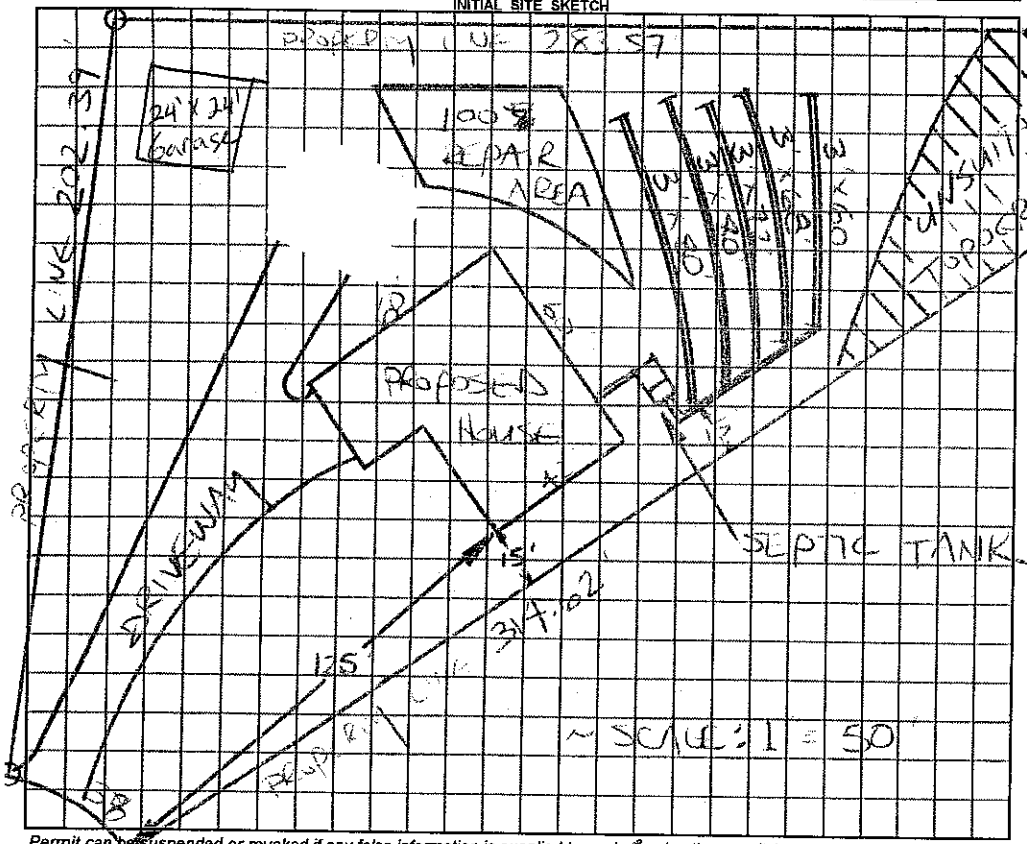

AS BUILT SKETCH

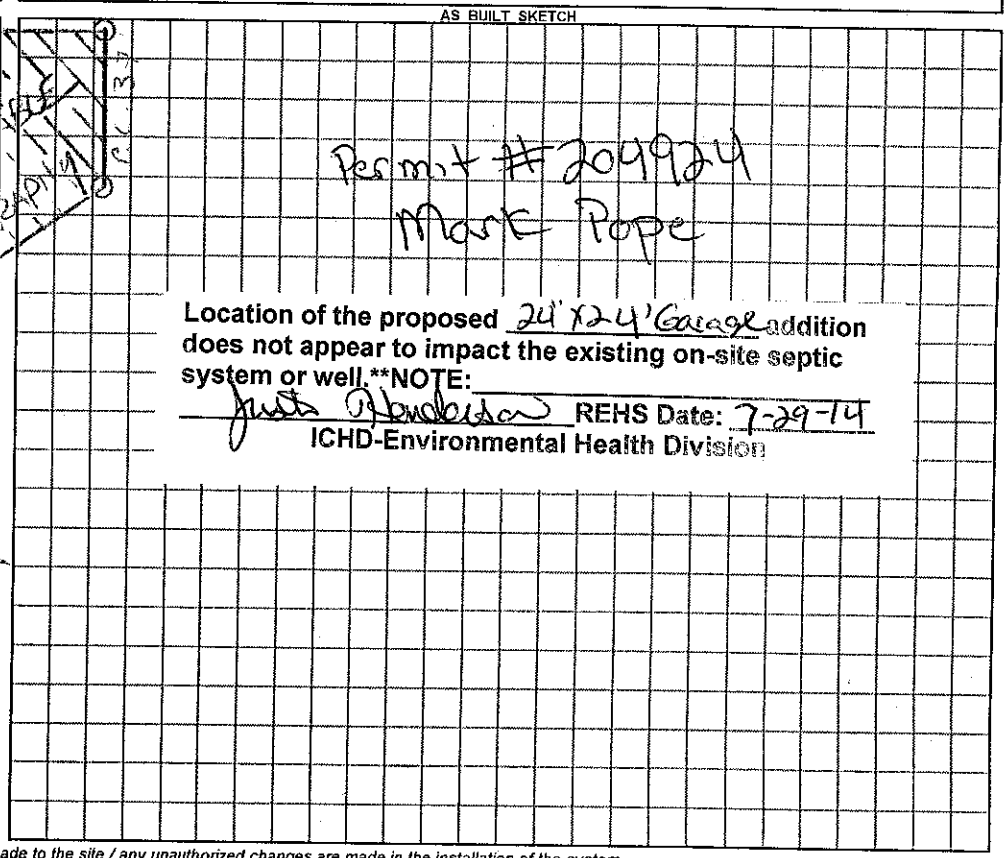

Permit #209924
Mark Pope

Location of the proposed 24'x24' Garage addition does not appear to impact the existing on-site septic system or well. **NOTE:**

Justin Henderson REHS Date: 7-29-14
ICHD-Environmental Health Division

Permit can be suspended or revoked if any false information is supplied toward securing the permit / any unauthorized changes are made to the site / any unauthorized changes are made in the installation of the system.

☐ ***IMPROVEMENT PERMIT*** *with plat valid without expiration.* ☑ ***IMPROVEMENT PERMIT*** *with plat valid without expiration.* ***site plan valid 60 mo.*** ☐ ***AUTHORIZATION TO CONSTRUCT*** valid for period equal to IMPROVEMENT PERMIT–not to exceed 60 mo.

Owner / Applicant Signature: ____ Date 4/24/12 Installed by: ____

IMPROVEMENT PERMIT by: STEVE HODGE ***REHS*** Date 4-24-12

AUTHORIZATION TO CONSTRUCT by: D K Hanson ***REHS*** Date 9-26-13

OPERATION PERMIT by: ____ ***REHS*** Date ____

System Inspected by: ____ ***REHS*** Date ____

YOU SHOULD CONTACT A LOCATOR SERVICE PRIOR TO ANY EXCAVATION

White Copy – Environmental Health YELLOW COPY (Final) Owner / Applicant PINK COPY (Initial) Owner / Applicant