IREDELL COUNTY HEALTH DEPARTMENT - *ENVIRONMENTAL HEALTH* ☐ STATESVILLE OFFICE 704-878-5305 ☐ MOORESVILLE OFFICE 704-664-5281

IMPROVEMENT PERMIT / AUTHORIZATION TO CONSTRUCT / OPERATION PERMIT / EXISTING SYSTEM INSPECTION

PERMIT # 171678 PIN # 4751-17-2720 DATE APRIL 24, 2012

OWNER JULIANNE S. HELMS APPLICANT: SAME PHONE: Home/Cell # 704-483-7930 Business # 352-250-9952

SITE ADDRESS 116 TREESIDE COURT OWNER / APPLICANT ADDRESS

SITE DIRECTIONS PILCH ROAD TO PEAR TREE ROAD, TR FIELDHAVEN PLACE, TREESIDE COURT, LOT AT END of CUL-DE-SAC

SUBDIVISION KELLY FARMSTEADS BLOCK / SECTION P3 S2 LOT # 31 LOT AREA 10.85 ACRE DESIGN FLOW 360 L.T.A.R. 0.25 gpd/ft²

Septic Tank 1000 Gallons: STB 1012 Date 1-19-14 ☑ New System ☐ Repair ☐ Expansion System Type I II III IV V VI ☑ Residence No. Bedrooms 3 Water Supply

Pump Tank N/A Gallons: P T N/A Date N/A System Description: 25% REDUCTION, GRAVITY ☐ Business No. Persons ☑ Private WELL

Pump Make N/A Model Infiltrator Serial # EF-4 Repair System Description: 50% REDUCTION, LOW-PRESS ☐ Other No. Employees ☐ Public


No. Nitrification Fields: 1 No. Lines 5 Linear Feet 360 Maintenance Agreement Required ☐ YES ☑ NO ☐ Slab ☐ Crawl Space ☐ Community

Trench Width 36" Max. Trench Bottom Depth 36" Gravel Depth NA ☑ GRAVITY ☐ PRESSURE ☑ Basement w/plumbing ☐ Basement w/o plumbing

Comments / Conditions INSTALL 25% REDUCTION SYSTEM ON CONTOUR AS SHOWN, USING SERIAL DISTRIBUTION

9-26-13 Reviewed floor plan. It substantially fits within current footprint on site sketch, therefore there is no need to redraw permit. JEH

INITIAL SITE SKETCH

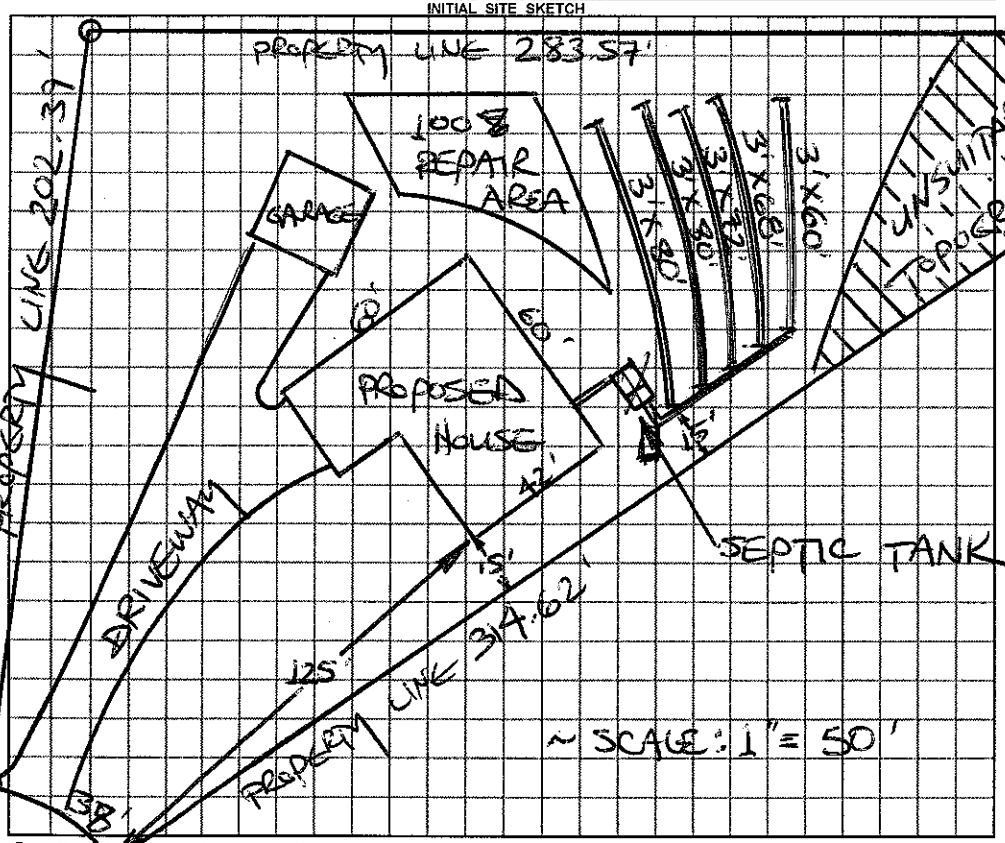

AS BUILT SKETCH

Installed Quick as drawn

Permit can be suspended or revoked if any false information is supplied toward securing the permit / any unauthorized changes are made to the site / any unauthorized changes are made in the installation of the system.

☐ ***IMPROVEMENT PERMIT*** with plat valid without expiration. ☑ ***IMPROVEMENT PERMIT*** with plat ~~valid without expiration~~ site plan valid 60 mo. ☐ ***AUTHORIZATION TO CONSTRUCT*** valid for period equal to IMPROVEMENT PERMIT--not to exceed 60 mo.

Owner / Applicant Signature: Julianne S Helms Date 4/30/12 Installed by: Yountz Grading

IMPROVEMENT PERMIT by: STEVE HENDRICK REHS Date 4-24-12 OPERATION PERMIT by: REHS Date 05/20/14

AUTHORIZATION TO C REHS Date 9-26-13 Existing System Inspected by: REHS Date

YOU SHOULD CONTACT A LOCATOR SERVICE PRIOR TO ANY EXCAVATION

White Copy – Environmental Health YELLOW COPY (Final) Owner / Applicant PINK COPY (Initial) Owner / Applicant