IREDELL COUNTY HEALTH DEPARTMENT

STATESVILLE 704-878-5305 MOORESVILLE 704-664-5281

IMPROVEMENT PERMIT / AUTHORIZATION TO CONSTRUCT / OPERATION PERMIT / EXISTING SYSTEM INSPECTION

PERMIT# 135747 PIN# 4751-17-7152 DATE 05/31/06

OWNER OR APPLICANT RUSS SMITH PHONE: Business 704-350-4205 Home 704-793-1536

ADDRESS #8877 HIDDEN FOREST LN. DAVIDSON, NC 28036

LOCATION I-77 S, (L) AMITY HILL RD, (R) PITCH RD, STRAIGHT TO PEAR TREE RD., (R) GRAY BARN DR., 3RD. LOT ON RIGHT IN CURVE,

SUBDIVISION KELLY FARMSTEAD BLOCK / SECTION II LOT 10 LOT AREA 0.865 Ac. SITE CLASS. PS DESIGN FLOW 360 GPD L.T.A.R. 0.30 GPD/FT²

Septic Tank: 1,000 Gallons; STB 825 Date 08/06/06
Pump Tank: _____ Gallons; PT _____ Date _____
Pump Make: _____ Model _____ Serial No. _____
Nitrification Field: No Fields 1 Square Feet EQ to 1,200 Linear Feet 300
No Lines 3@100' Trench Width 36" Max Trench Bottom Depth 36"

☒ New System ☐ Repair ☐ Expansion System Type: I (II) III IV V VI
System Description: GRAVITY, 25% REDUCTION
Repair System Description: LOW PRESSURE, 50% REDUC.
Maintenance Agreement Required: ☐ Yes ☒ No

☒ House/Mod. Home No. Bedrooms 3
☐ Mobile Home No. Persons ____
☐ Business No. Employees ____
☐ Other ____

Water Supply: ☒ Individual WELL ☐ Public ☐ Community


Gravel Depth N/A ☒ Gravity ☐ Pressure ☐ Slab ☐ Crawl Space ☐ Basement w/plumbing ☒ Basement wo/plumbing

Comments:/Conditions:


Comments:/Conditions:

* TUFF TIGHT FROM 3D ST.

INITIAL SITE SKETCH

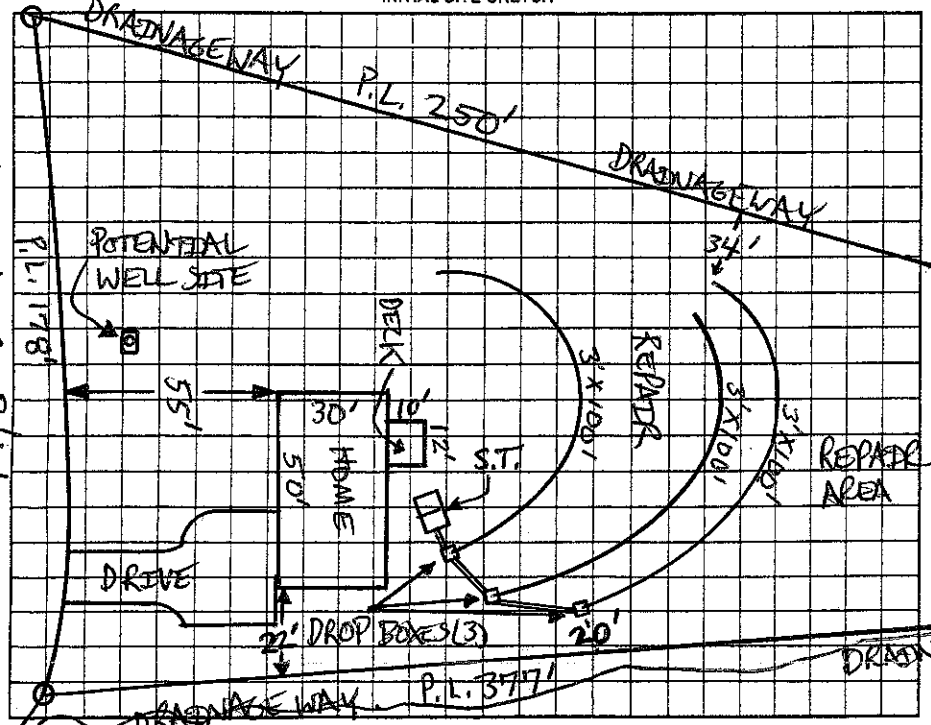

AS BUILT SKETCH

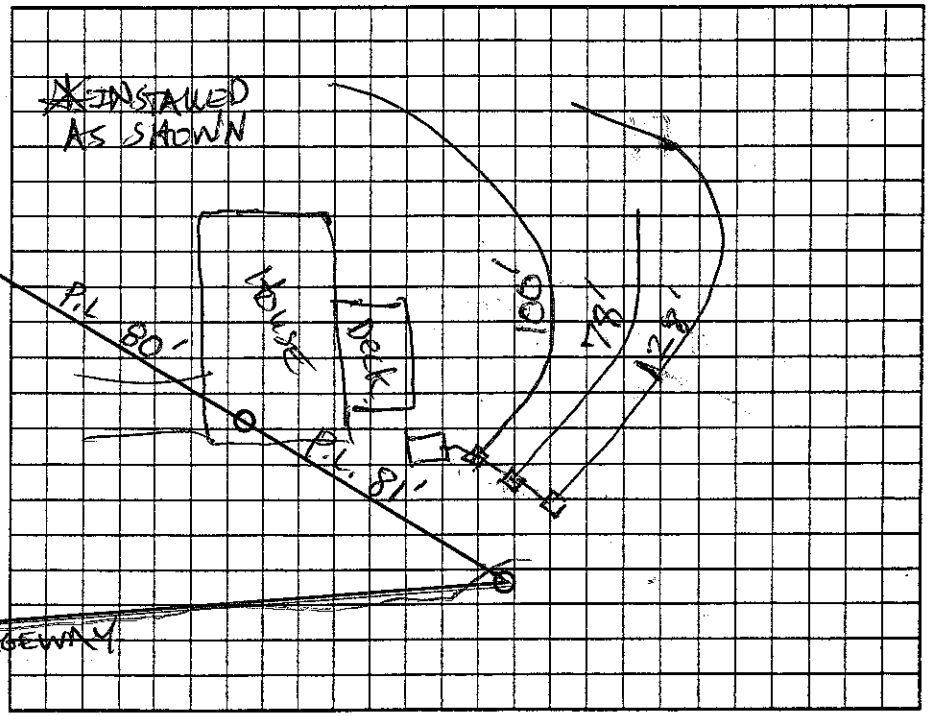

Permit can be suspended or revoked if any false information is supplied toward securing the permit/any unauthorized changes are made to the site/any unauthorized changes are made in the installation of the system. Improvement Permit with plat valid without expiration ☐ Improvement Permit with site plan valid for sixty months ☒ Authorization to Construct is valid for a period equal to that of Improvement Permit – not to exceed sixty months.

Signed: Russell Smith date 5/31/06 Installed by: ROWAN SEPTIC

Improvement Permit by: STEVE HEDRICK date 5-31-06 Operation Permit by: [signature] date 09/21/06

Authorization to Construct by: STEVE HEDRICK date 5-31-06 Existing System Inspection by: _____ date _____

HEALTH DEPT. COPY: WHITE OWNER COPY (FINAL): YELLOW OWNER COPY (INITIAL): PINK