IREDELL COUNTY HEALTH DEPARTMENT

STATESVILLE 704-878-5305 (C1) MOORESVILLE 704-664-5281

IMPROVEMENT PERMIT / AUTHORIZATION TO CONSTRUCT / OPERATION PERMIT / EXISTING SYSTEM INSPECTION

PERMIT# 111881 PIN# 4751-17-8637 DATE 06/06/03

OWNER OR CONTRACTOR LANCE LAUFFENBURGER PHONE: Business Home 704-528-2000 704-663-5592

ADDRESS 108 OUTSIDE LP. MOORESVILLE, NC 28117

LOCATION I77 SOUTH, (L) AMITY HILL, (R) PILCH, STRAIGHT TO PEAR TREE, (R) GRAY BARN, (R) MIDWOOD Ln., @ END OF CUL-DE-SAC.

SUBDIVISION KELLY FARMSTEAD BLOCK / SECTION 1 LOT 18 LOT AREA 1.02 ACRES SITE CLASS. PS DESIGN FLOW 360 GPD L.T.A.R. 0.30 GPD/FT²

Septic Tank: 1,000 Gallons; STB 1007 Date 12-2-03
Pump Tank: ____ Gallons; PT ____ Date ____
Pump Make: ____ Model ____ Serial No. ____
Nitrification Field: No Fields 1 Square Feet EQ to 1,200 Linear Feet 300
No Lines 6 @ 50' Trench Width 36" Max Trench Bottom Depth 36" Gravel Depth N/A

[X] New System [ ] Repair System Type: I, II, (III) IV, V, VI
System Description: 25% REDUCTION, GRAVITY
Repair System Description: 50% REDUCTION, L.P.
Maintenance Agreement Required: [ ] Yes [X] No


[X] House/Mod. Home No. Bedrooms 3
[ ] Mobile Home No. Bathrooms 2
[ ] Business No. Employees ____
[ ] Other ____
[ ] Slab [ ] Crawl Space [ ] Basement w/plumbing [X] Basement wo/plumbing

Water Supply: [X] Individual [ ] Public [ ] Community WELL

Comments/Conditions: (1) NO EXCAVATING OR GRADING BEYOND PROPOSED HOME SITE, (2) MAINTAIN 15'+ SIDESLOPE SETBACK FROM BASEMENT CUT, (3) CALL AFTER CLEARING

Comments/Conditions: → FOR REFLAGGING IF NEEDED, SEPTIC TANK WITH MARKER INSTALLED USING "TRENTE" FILTER

INITIAL SITE SKETCH

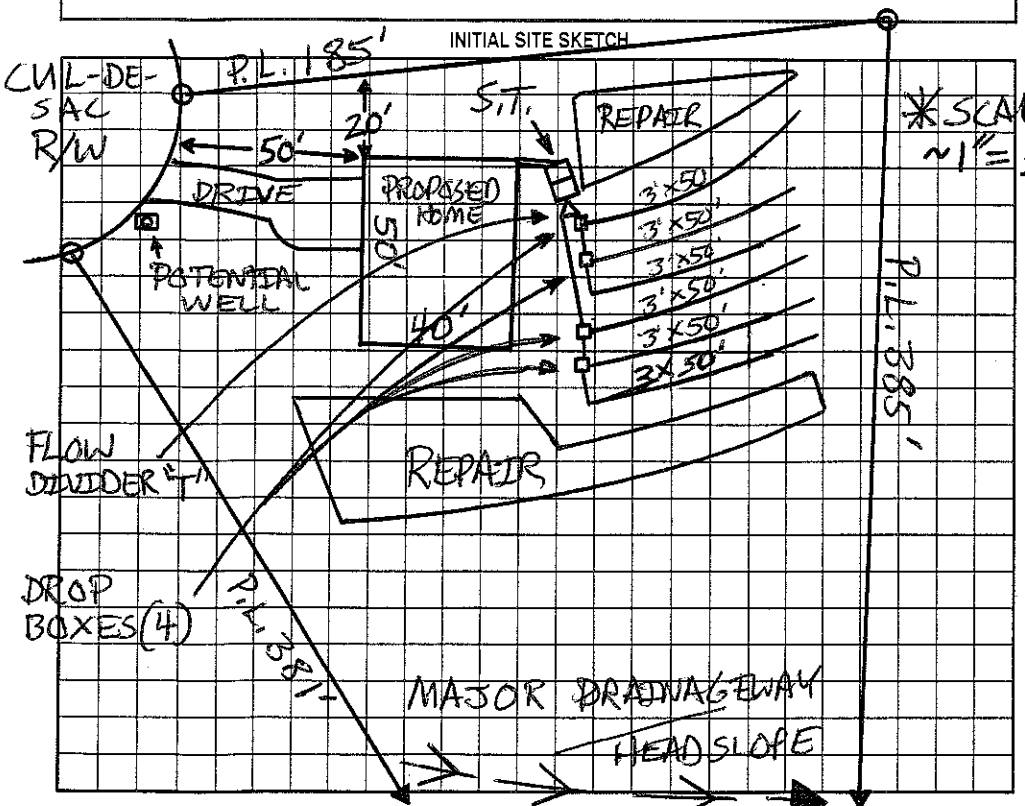

AS BUILT SKETCH

SYSTEM INSTALLED USING "INFILTRATOR" QUICK 4 CHAMBER) 27% REDUCTION W/ WARRANTY

Permit can be suspended or revoked if any false information is supplied toward securing the permit/any unauthorized changes are made to the site/any unauthorized changes are made in the installation of the system. Improvement Permit with plat valid without expiration. Improvement Permit with site plan valid for sixty months. Authorization to Construct is valid for a period equal to that of Improvement Permit – not to exceed sixty months.

Signed: [signature] date 6/4-03 Installed by: A&S GRADING

Improvement Permit by: [signature] date 06/06/03 Operation Permit by: STEVE HENRICK date 3-5-04

Authorization to Construct by: [signature] date ____ Existing System Inspection by: ____ date ____

HEALTH DEPT. COPY: WHITE OWNER COPY (FINAL): YELLOW OWNER COPY (INITIAL): PINK