# IREDELL COUNTY HEALTH DEPARTMENT

STATESVILLE 704-878-5305 MOORESVILLE 704-664-5281

## IMPROVEMENT PERMIT / AUTHORIZATION TO CONSTRUCT / OPERATION PERMIT / EXISTING SYSTEM INSPECTION

PERMIT# 136897 PIN# 4751179176

OWNER OR APPLICANT Ken Griffin DATE 5-6-08

ADDRESS 124 Painted Bunting Drive Troutman NC 28166 PHONE: Business 704-7465366 Home

LOCATION I-77 South (R) Ashe Hill (R) Pitch Straight Peachtree (R) Graybarn

SUBDIVISION Kelly Farmstead BLOCK / SECTION 0 LOT 9 LOT AREA 1.021 SITE CLASS. PS DESIGN FLOW 360 L.T.A.R. .33

Septic Tank: 1000 Gallons: STB Date

Pump Tank: Gallons: PT Date

Pump Make: Model Serial No.

Nitrification Field: No Fields 1 Square Feet 1030 Linear Feet 260

No Lines 4 @ 65 Trench Width 36" Max Trench Bottom Depth 26" Gravel Depth NA ☒ Gravity ☐ Pressure

☒ New System ☐ Repair ☐ Expansion System Type: I II (III) IV V VI

System Description: 25% Reduct - Gravity

Repair System Description: 25% Pump

Maintenance Agreement Required: ☐ Yes ☒ No

☒ House/Mod. Home ☐ Mobile Home ☐ Business ☐ Other

No. Bedrooms 3 No. Persons No. Employees


Water Supply: ☒ Individual ☐ Public ☐ Community

☐ Slab ☐ Crawl Space ☒ Basement w/plumbing ☐ Basement wo/plumbing

Comments:/Conditions:
1) Max Trench Bottom 26"
2) DON'T cut or grade septic

Comments:/Conditions:
Red Lot Tile
Yellow Septic Marker

INITIAL SITE SKETCH

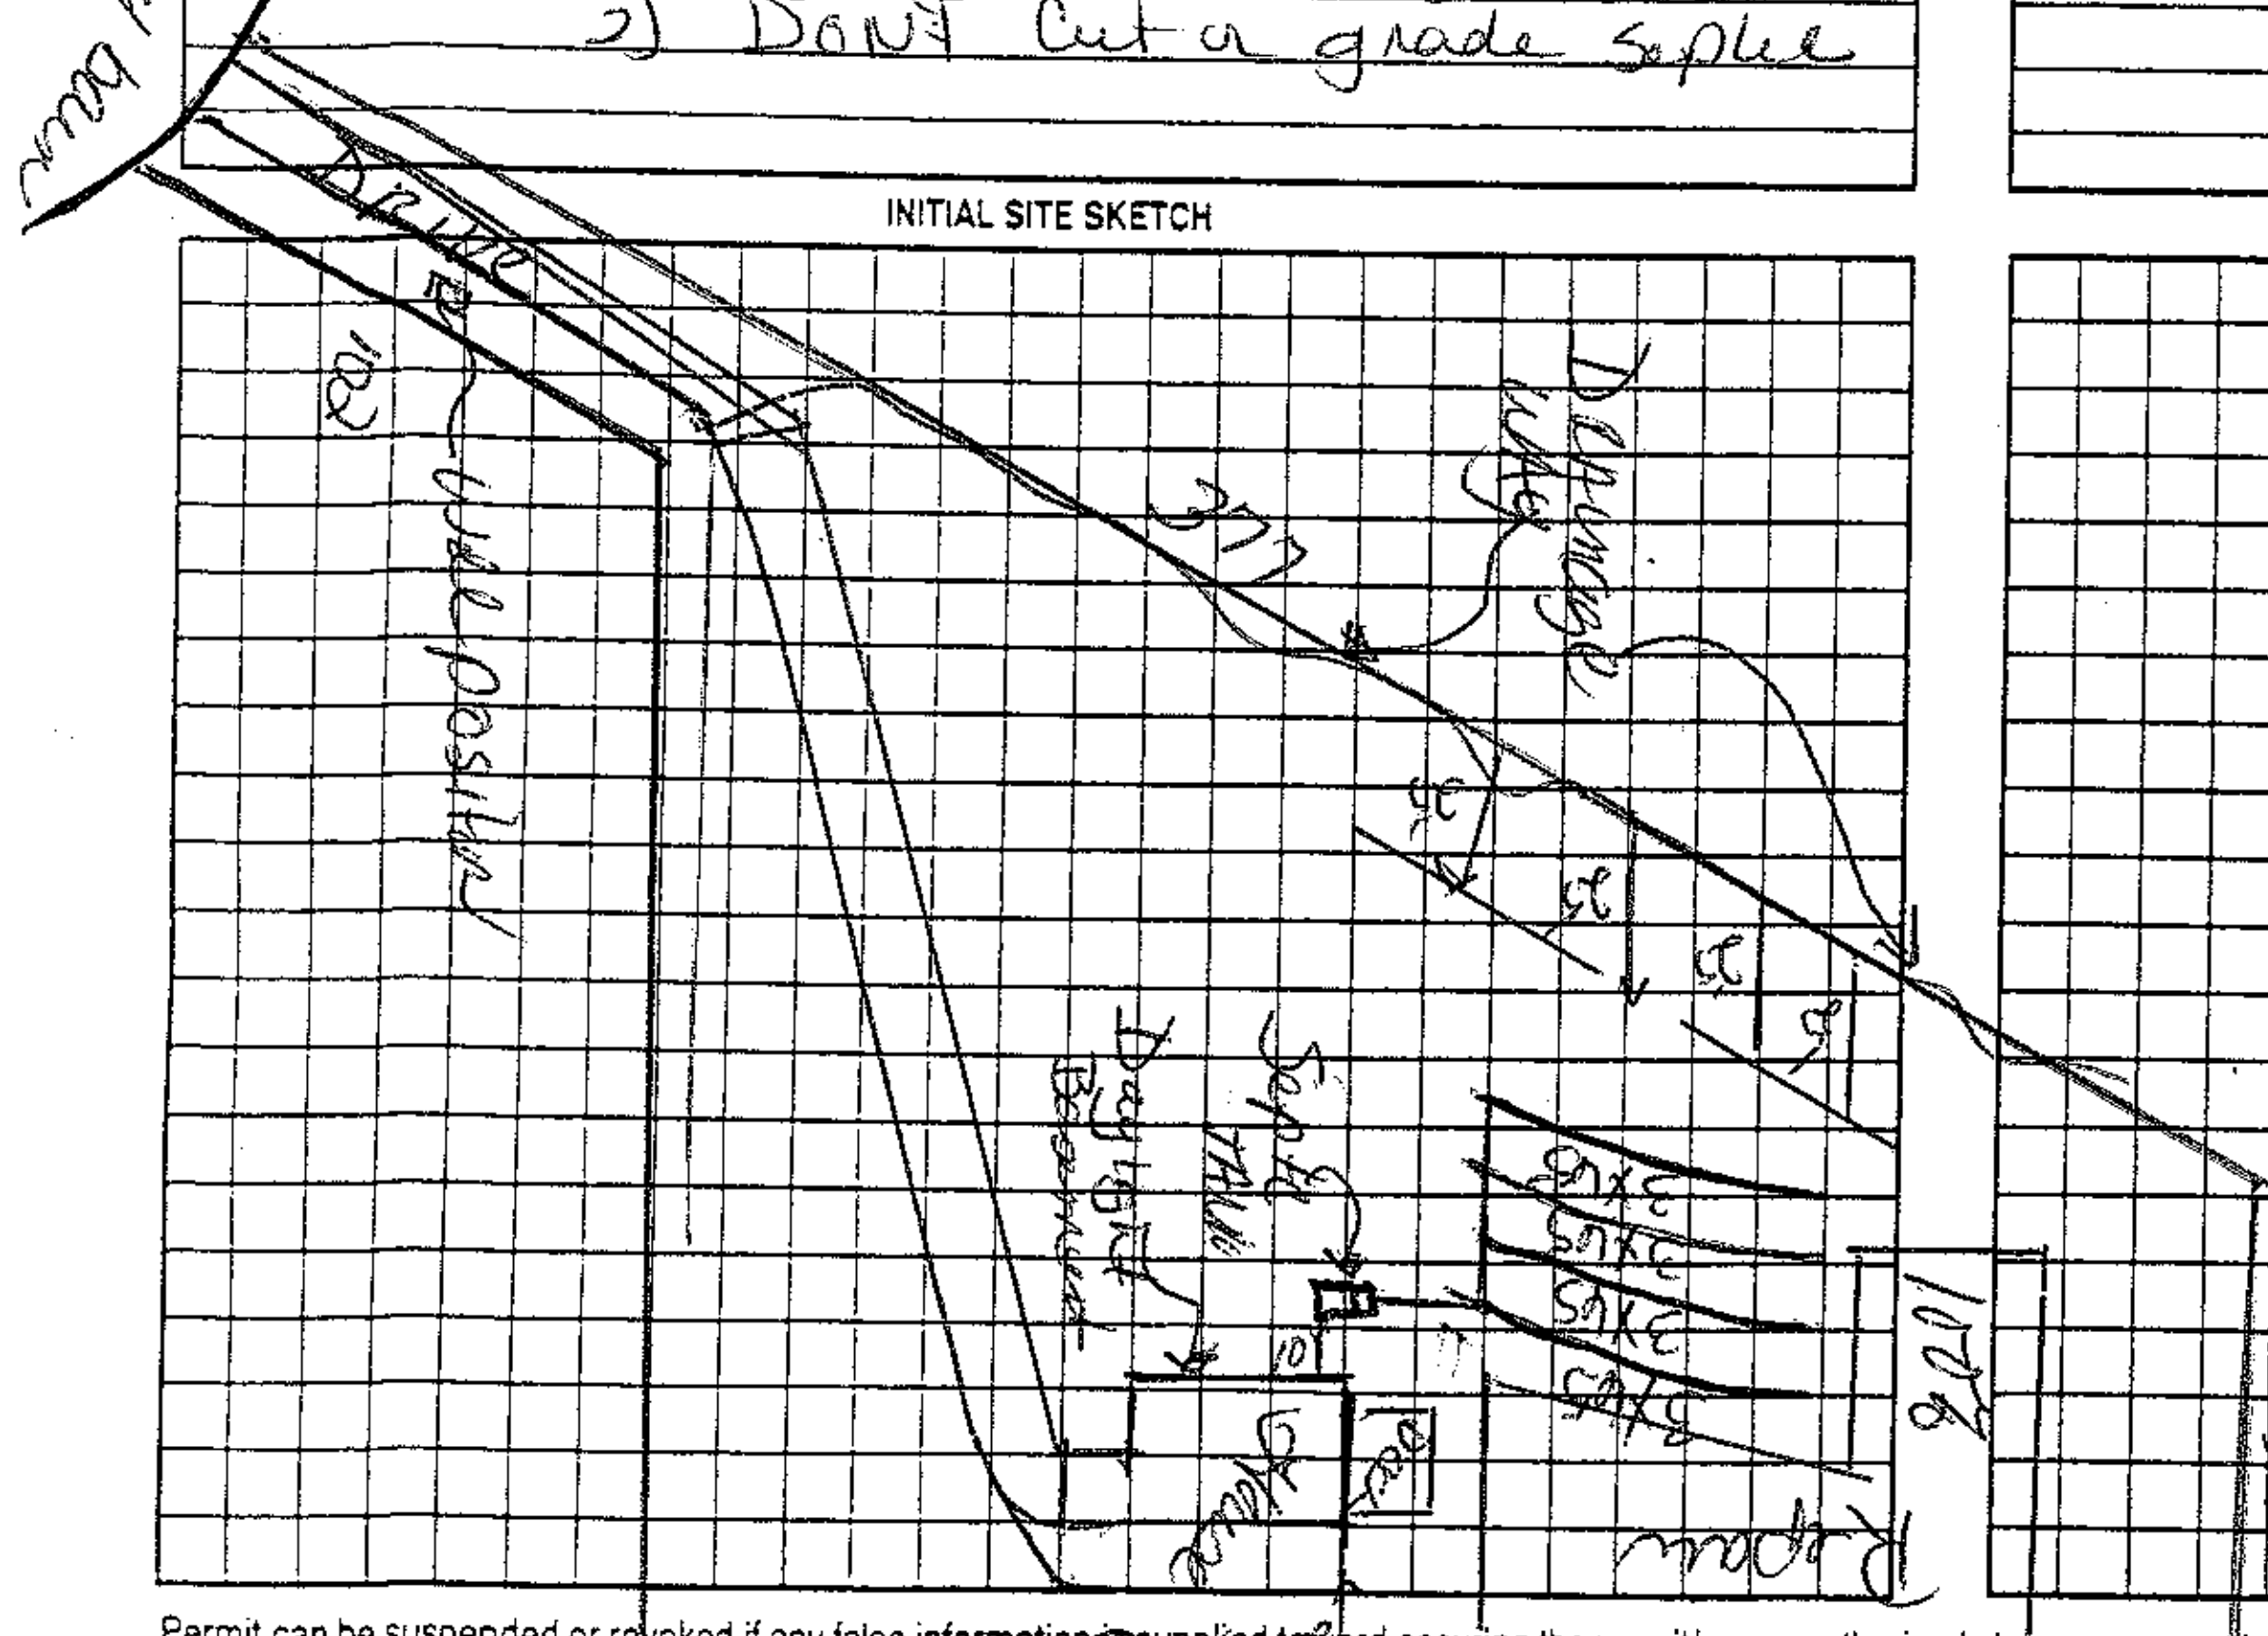


AS BUILT SKETCH

Permit can be suspended or revoked if any false information is supplied toward securing the permit/any unauthorized changes are made to the site/any unauthorized changes are made in the installation of the system. Improvement Permit with plat valid without expiration ☐ Improvement Permit with site plan valid for sixty months ☒ Authorization to Construct is valid for a period equal to that of Improvement Permit – not to exceed sixty months.

Signed: T Rebecca Call date

Improvement Permit by: Keith Cook date 5-6-08

Authorization to Construct by: Keith Cook date 5-6-08

Installed by: Mark Myers

Operation Permit by: Keith Cook date 5-6-08

Existing System Inspection by: date

HEALTH DEPT. COPY: WHITE OWNER COPY (FINAL): YELLOW OWNER COPY (INITIAL): PINK