IREDELL COUNTY HEALTH DEPARTMENT - *ENVIRONMENTAL HEALTH* ☑ STATESVILLE OFFICE 704-878-5305 ☐ MOORESVILLE OFFICE 704-664-5281

IMPROVEMENT PERMIT / AUTHORIZATION TO CONSTRUCT / OPERATION PERMIT / EXISTING SYSTEM INSPECTION

PERMIT # 174299 PIN # 4751179544 DATE 10-2-12

OWNER Keith Kelly APPLICANT: DB Custom Homes PHONE: Home/Cell # 704-701-6532 Business # N/A

SITE ADDRESS 121 Midwood Ln OWNER / APPLICANT ADDRESS 764 Morrison Farm Rd. Troutman

SITE DIRECTIONS Hwy 21 S TL Ostwalt Amity Rd. TL Pilch Rd TL Pear Tree TR TR Kelly Farmsteads Sub. TR Midwood Ln.

SUBDIVISION Kelly Farmsteads BLOCK / SECTION P3 S1 LOT # 17 LOT AREA 1.42 acres DESIGN FLOW 360 gpd L.T.A.R. 0.3


Septic Tank 1000	Gallons: STB 781	Date 5-14-12	☑ New System ☐ Repair ☐ Expansion System Type I II III IV V VI	☑ Residence	No. Bedrooms 3	Water Supply
Pump Tank	Gallons: PT	Date	System Description: 25% Reduction - Gravity	☐ Business	No. Persons	☑ Private
Pump Make	Model	Serial #	Repair System Description: 25% Reduction - Pump	☐ Other	No. Employees	☐ Public
No. Nitrification Fields: 1	No. Lines 4	Linear Feet 300	Maintenance Agreement Required ☐ YES ☑ NO	☐ Slab	☐ Crawl Space	☐ Community
Trench Width 36"	Max. Trench Bottom Depth 36"	Gravel Depth N/A	☑ GRAVITY ☐ PRESSURE	☑ Basement w/plumbing	☐ Basement w/o plumbing	

Comments / Conditions Install a 25% Reduction System on Contour with serial distribution.


THIS PERMIT REPLACES PREVIOUS ISSUED 5/19/2004

- 2" PVC septic tank risers installed
- Blue Polylok filter installed
- Quick 4 Chambers installed.

INITIAL SITE SKETCH

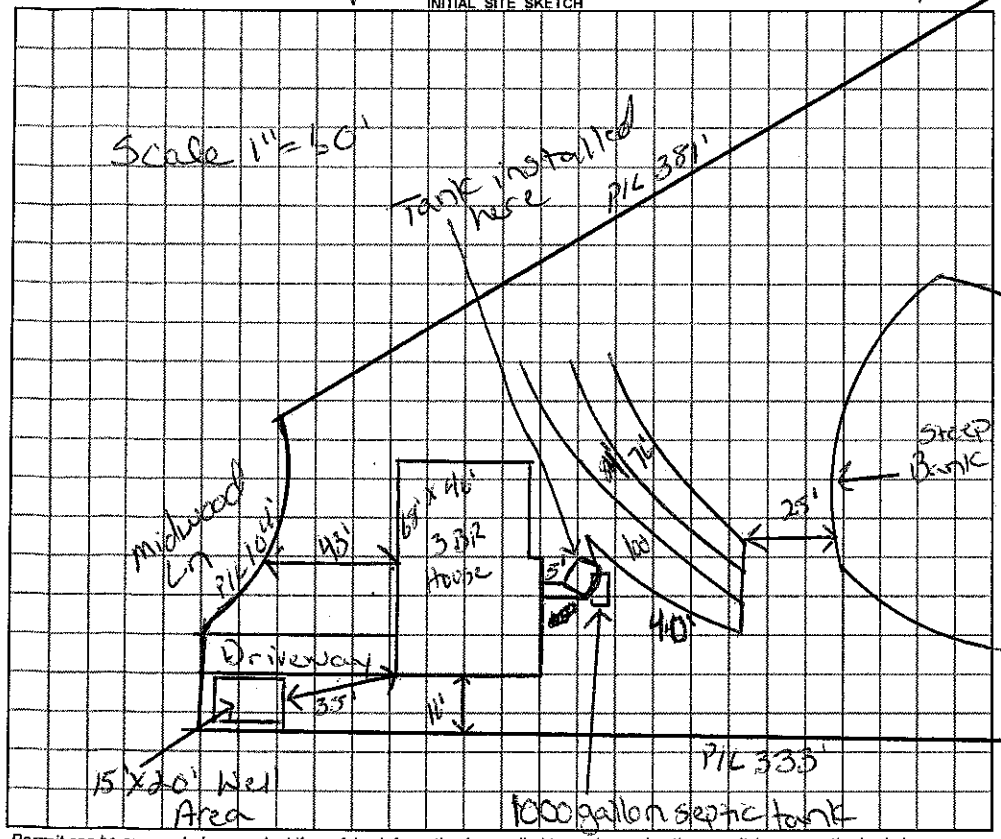

AS BUILT SKETCH

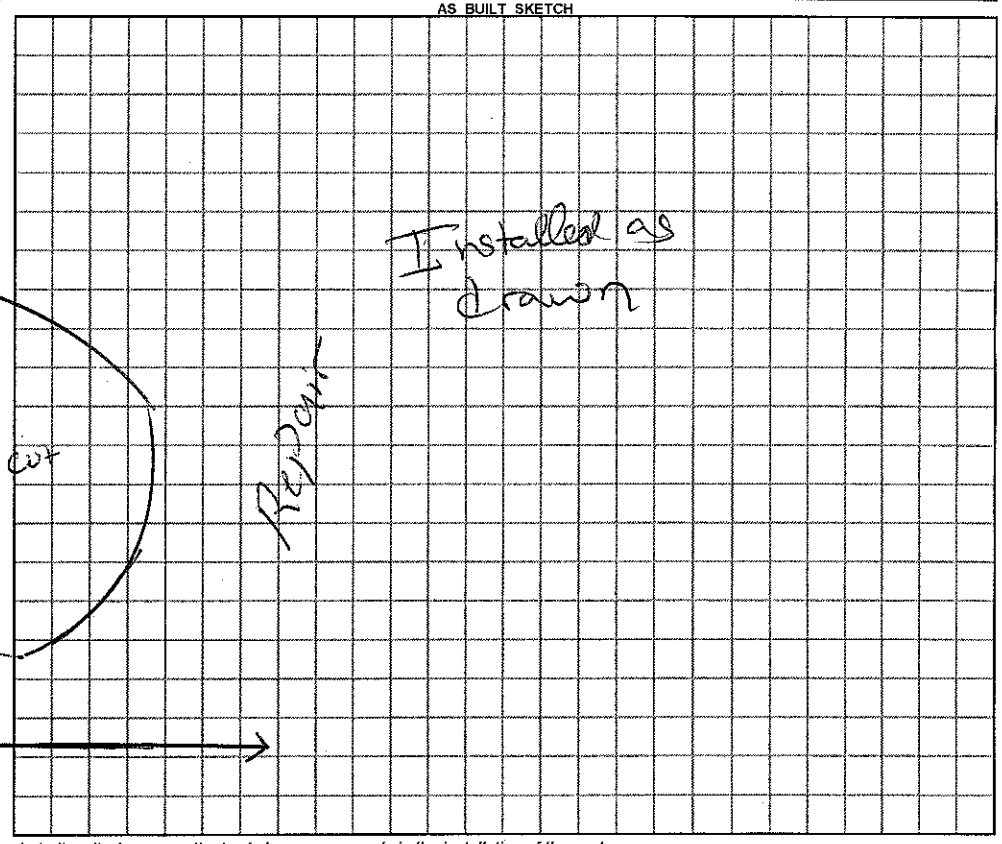

Permit can be suspended or revoked if any false information is supplied toward securing the permit / any unauthorized changes are made to the site / any unauthorized changes are made in the installation of the system.

☐ ***IMPROVEMENT PERMIT*** with plat valid without expiration. ☑ ***IMPROVEMENT PERMIT*** with ~~plat valid without expiration~~ site plan valid 60 mo. ☑ ***AUTHORIZATION TO CONSTRUCT*** valid for period equal to IMPROVEMENT PERMIT--not to exceed 60 mo.

Owner / Applicant Signature: _____ Date _____ Installed by: Adan Garcia

IMPROVEMENT PERMIT by: Justin Henderson REHS Date 10-2-12 OPERATION PERMIT by: Justin Henderson REHS Date 10-25-12

AUTHORIZATION TO CONSTRUCT by: Justin Henderson REHS Date 10-2-12 Existing System Inspected by: _____ REHS Date _____

YOU SHOULD CONTACT A LOCATOR SERVICE PRIOR TO ANY EXCAVATION

White Copy – Environmental Health YELLOW COPY (Final) Owner / Applicant PINK COPY (Initial) Owner / Applicant