IREDELL COUNTY HEALTH DEPARTMENT

STATESVILLE 704-878-5305 MOORESVILLE 704-664-5281

4751209703

IMPROVEMENT PERMIT / CERTIFICATE OF COMPLETION / OPERATION PERMIT / EXISTING SYSTEM INSPECTION

PROPERTY DESCRIPTION NO. 17828 DATE 2/21/94 TAX MAP NO. 4L-3 A 5 Watershed: ☐ Yes ☑ No

OWNER OR CONTRACTOR JERRY WILSON PHONE: Business _____ Home 663-2062

ADDRESS R#11 Box 424 MOORESVILLE, NC 28115

LOCATION CHARLOTTE HWY OFF I-15 TR ON FRANKLINWOODS STRAIGHT TO STOP, TL ON SUMMERTREE, CULDESAC ON R

SUBDIVISION SUMMERTREE BLOCK / SECTION _____ LOT 5 LOT AREA 2+/- AC SITE CLASS. P DESIGN FLOW 240 L.T.A.R. .2-.25

Septic Tank: 1000 Gallons; STB 794 Date 11/25/93

Pump Tank: _____ Gallons; PT _____ Date _____

Pump Make: _____ Model _____ Serial No. _____

Nitrification Field: No Fields 1 Square Feet 960 Linear Feet 320

No Lines 3 Trench Width 3' Max Trench Bottom Depth 32" Gravel Depth 12"

☑ New System ☐ Repair System Type: I, II, III, IV, V, VI

System Description: CONV-DIST BOX

Repair System Description: SAME

Maintenance Agreement Required: ☐ Yes ☑ No

☐ House/Mod. Home No. Bedrooms 3

☑ Mobile Home No. Bathrooms 1

☐ Business No. Employees ____

☐ Other _____


☐ Slab ☑ Crawl Space ☐ Basement w/plumbing ☐ Basement wo/plumbing

Water Supply: ☑ Individual ☐ Community ☐ Public

Comments: WOODS WELL

Comments:

INITIAL SITE SKETCH

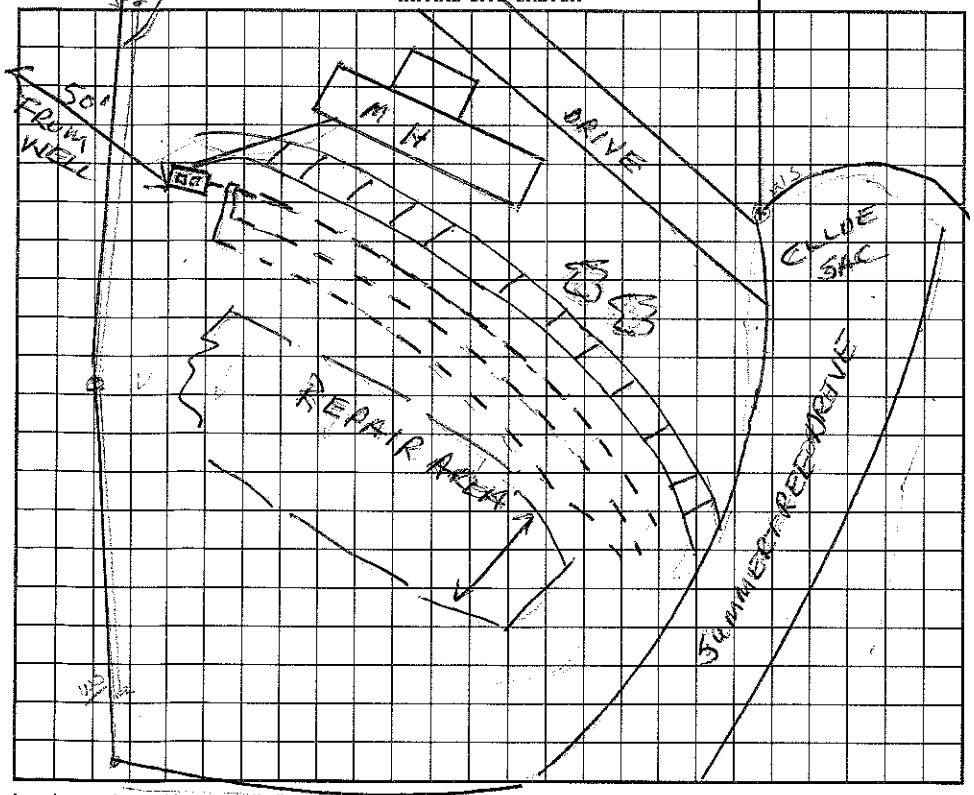

AS BUILT SKETCH

Installed as drawn

I understand that this permit can be suspended or revoked if any false information is supplied toward securing the permit/any unauthorized changes are made to the site/any unauthorized changes are made in the installation of the system. Improvement Permit is valid for 60 months from date of issuance.

Signed: _____

Improvement Permit by: Wesley Sparks R.S. date 2/21/94

Existing System Inspection by: _____ date _____

Installed by: Dellinger Septic Tanks

Certificate of Completion by: Wesley Sparks R.S. date 3/9/94

Operation Permit by: _____ date _____

HEALTH DEPT. COPY: WHITE INSPECTION COPY (FINAL): GREEN OWNER COPY (FINAL): YELLOW INSPECTION COPY (INITIAL): PINK OWNER COPY (INITIAL): GOLD