IREDELL COUNTY HEALTH DEPARTMENT

STATESVILLE 704-878-5305 MOORESVILLE 704-664-5281

IMPROVEMENT PERMIT / AUTHORIZATION TO CONSTRUCT / OPERATION PERMIT / EXISTING SYSTEM INSPECTION

PERMIT# 075794 PIN# 4751217638 DATE 9/4/98

OWNER OR CONTRACTOR W. T Overcash PHONE: Business Home 528-5303

ADDRESS 462 Oswalt Amity Rd Troutman NC

LOCATION Hwy 115N TR Oswalt Amity Hill ~ 1 mile on Rt past Baptist Church on Rt

SUBDIVISION Existing BLOCK / SECTION LOT LOT AREA SITE CLASS. PS DESIGN FLOW Existing

Septic Tank: Existing Gallons; STB Date

Pump Tank: Gallons; PT Date

Pump Make: Model Serial No.

Nitrification Field: No Fields Square Feet Linear Feet

No Lines Trench Width Existing Max Trench Bottom Depth Gravel Depth

☐ New System ☐ Repair System Type: I, II, III, IV, V, VI

System Description:

Repair System Description: Existing

Maintenance Agreement Required: ☐ Yes ☐ No

☐ House/Mod. Home No. Bedrooms 3

☒ Mobile Home No. Bathrooms 2

☐ Business No. Employees

☐ Other


☐ Slab ☐ Crawl Space ☐ Basement w/plumbing ☐ Basement wo/plumbing

Water Supply:
☒ Individual Shared
☐ Public
☐ Community

Comments:/Conditions: Existing System appears to be functioning Okay at time of inspection, No Problems Noticed.

Comments:/Conditions:

INITIAL SITE SKETCH Not to Scale

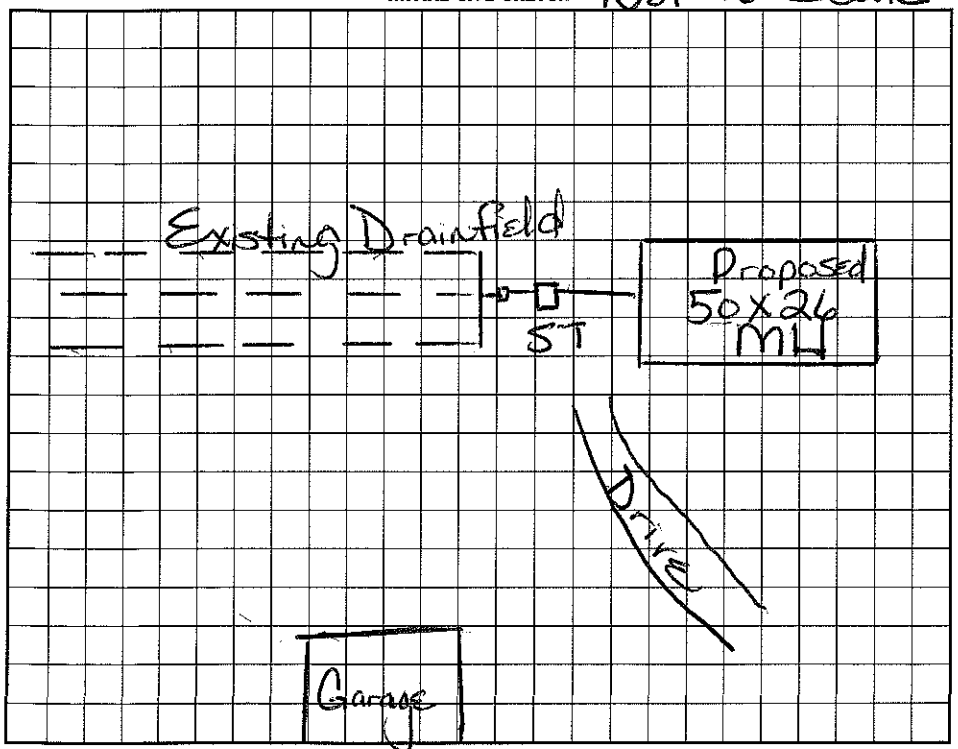

AS BUILT SKETCH

I understand that this permit can be suspended or revoked if any false information is supplied toward securing the permit/any unauthorized changes are made to the site/any unauthorized changes are made in the installation of the system. Improvement Permit with plat valid without expiration. Improvement Permit with site plan valid for sixty months. Authorization to Construct is valid for a period equal to that of Improvement Permit – not to exceed sixty months.

Signed: X W T Overcash date

Improvement Permit by: Maria H Dobson date 9/4/98

Authorization to Construct by: Maria H Dobson date 9/4/98

Installed by:

Operation Permit by: date

Existing System Inspection by: Maria Dobson date 9/4/98

HEALTH DEPT. COPY: WHITE INSPECTION COPY (FINAL): GREEN OWNER COPY (FINAL): YELLOW INSPECTION COPY (INITIAL): PINK OWNER COPY (INITIAL): GOLD