IREDELL COUNTY HEALTH DEPARTMENT - *ENVIRONMENTAL HEALTH* ☐ STATESVILLE OFFICE 704-878-5305 ☐ MOORESVILLE OFFICE 704-664-5281

IMPROVEMENT PERMIT / AUTHORIZATION TO CONSTRUCT / OPERATION PERMIT / EXISTING SYSTEM INSPECTION

PERMIT # 163943 PIN # 4751-22-1754 DATE 22 September 2011

OWNER Haydon Investments APPLICANT: Lane Harrell PHONE: Home/Cell # (704) 902-4659 Business #

SITE ADDRESS 423 Ostwalt Amity Rd. OWNER / APPLICANT ADDRESS

SITE DIRECTIONS Corner of Ostwalt Amity Rd and Pilot Rd.

SUBDIVISION Sparrows Pass BLOCK / SECTION LOT # 7 LOT AREA 0.7 ac. DESIGN FLOW 360 gpd L.T.A.R. 0.3 gpd/ft²

Septic Tank 1000 Gallons: STB 1012 Date 8-2-12 ☑ New System ☐ Repair ☐ Expansion System Type I II III IV V VI

Pump Tank Gallons: P T Date System Description: 25% Reduction System

Pump Make Model Serial # Repair System Description: 25% Reduction System

No. Nitrification Fields: 1 No. Lines 4 Linear Feet 300 Maintenance Agreement Required ☐ YES ☑ NO


Trench Width 36" Max. Trench Bottom Depth 36" Gravel Depth NA ☑ GRAVITY ☐ PRESSURE

☑ Residence No. Bedrooms 3 ☐ Business No. Persons ☐ Other No. Employees ☐ Slab ☑ Crawl Space ☐ Basement w/plumbing ☐ Basement w/o plumbing


Water Supply: ☑ Private ☐ Public ☐ Community

Comments / Conditions: Follow contour /

INITIAL SITE SKETCH

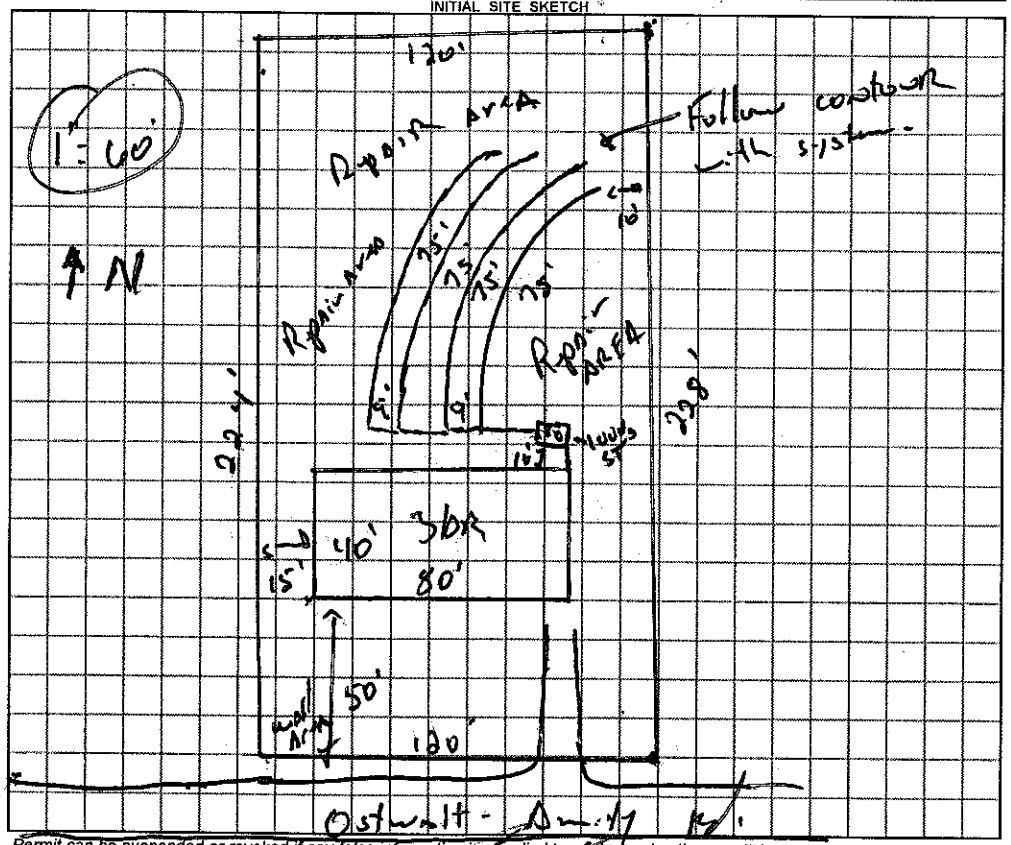

AS BUILT SKETCH

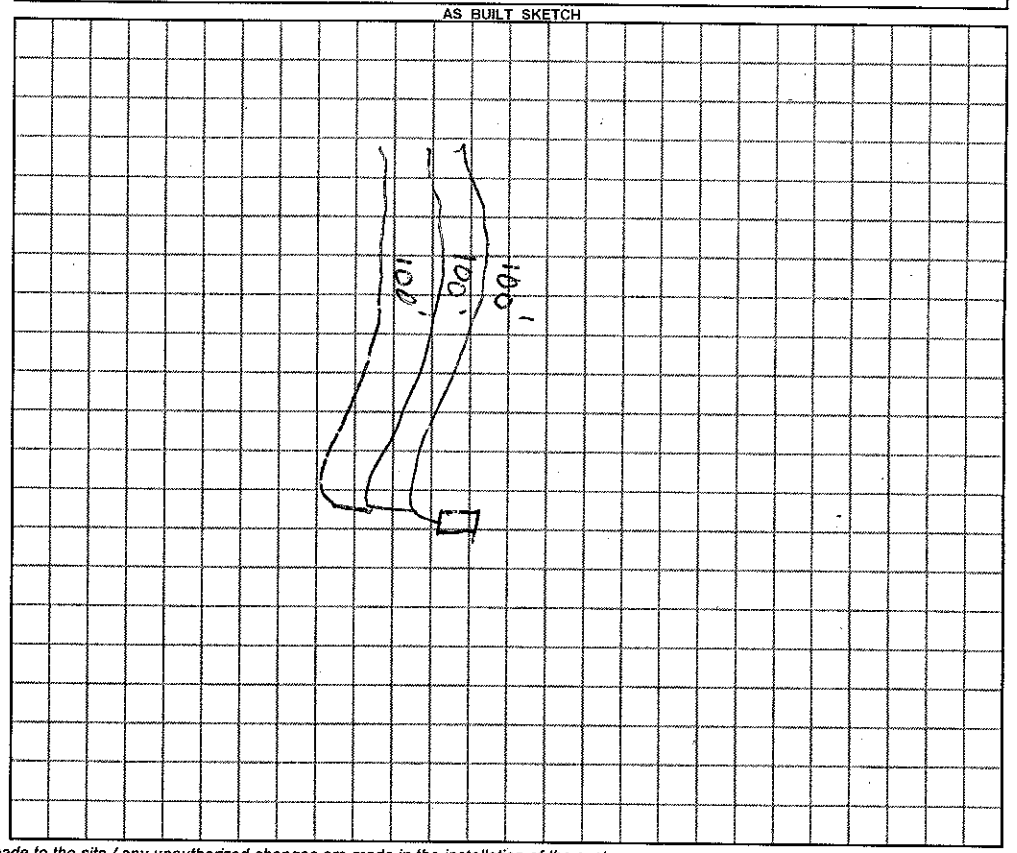

Permit can be suspended or revoked if any false information is supplied toward securing the permit / any unauthorized changes are made to the site / any unauthorized changes are made in the installation of the system.

☐ ***IMPROVEMENT PERMIT*** with plat valid without expiration. ☑ ***IMPROVEMENT PERMIT*** with ~~plat valid with expiration~~ site plan valid 60 mo. ☐ ***AUTHORIZATION TO CONSTRUCT*** valid for period equal to IMPROVEMENT PERMIT--not to exceed 60 mo.

Owner / Applicant Signature: Date 10/20/11 Installed by: Erye Grading

IMPROVEMENT PERMIT by: REHS Date 22 Sept. 11 OPERATION PERMIT by: REHS Date 7-17-13

AUTHORIZATION TO CONSTRUCT by: REHS Date 7-10-13 Existing System Inspected by: REHS Date

YOU SHOULD CONTACT A LOCATOR SERVICE PRIOR TO ANY EXCAVATION

White Copy – Environmental Health YELLOW COPY (Final) Owner / Applicant PINK COPY (Initial) Owner / Applicant