4751 22 2868

IREDELL COUNTY HEALTH DEPARTMENT - *ENVIRONMENTAL HEALTH* ☐ STATESVILLE OFFICE 704-878-5305 ☐ MOORESVILLE OFFICE 704-664-5281

IMPROVEMENT PERMIT / AUTHORIZATION TO CONSTRUCT / OPERATION PERMIT / EXISTING SYSTEM INSPECTION

PERMIT # 163937 PIN # 4751-22-2827 DATE 22 September 11

OWNER Hayden-I Investments, LLC APPLICANT: Lane Harrell PHONE: Home/Cell # (704) 902-4659 Business #

SITE ADDRESS 494 Pilch Rd. Troutman OWNER / APPLICANT ADDRESS

SITE DIRECTIONS Corner of Pilch Rd. & Oswalt Church Rd.

SUBDIVISION Sparrows Pass BLOCK / SECTION LOT # 4 LOT AREA 0.94 Ac. DESIGN FLOW 360 gpd L.T.A.R. 0.3,472 gpd

Septic Tank 1000 gal Gallons: STB 760 Date 10-16

Pump Tank gal Gallons: PT Date

Pump Make Model Serial #

No. Nitrification Fields: 1 No. Lines 4 Linear Feet 300

Trench Width 36" Max. Trench Bottom Depth 36" Gravel Depth NA

☑ New System ☐ Repair ☐ Expansion System Type I II ◉ IV V VI

System Description: 25% Reduction

Repair System Description: 25% Reduction

Maintenance Agreement Required ☐ YES ☑ NO

☑ GRAVITY ☐ PRESSURE

☑ Residence No. Bedrooms 3

☐ Business No. Persons

☐ Other No. Employees


☐ Slab ☑ Crawl Space

☐ Basement w/plumbing ☐ Basement w/o plumbing


Water Supply: ☑ Private ☐ Public ☐ Community

Comments / Conditions Follow contours / * Keep well 100' from septic syst.

INITIAL SITE SKETCH

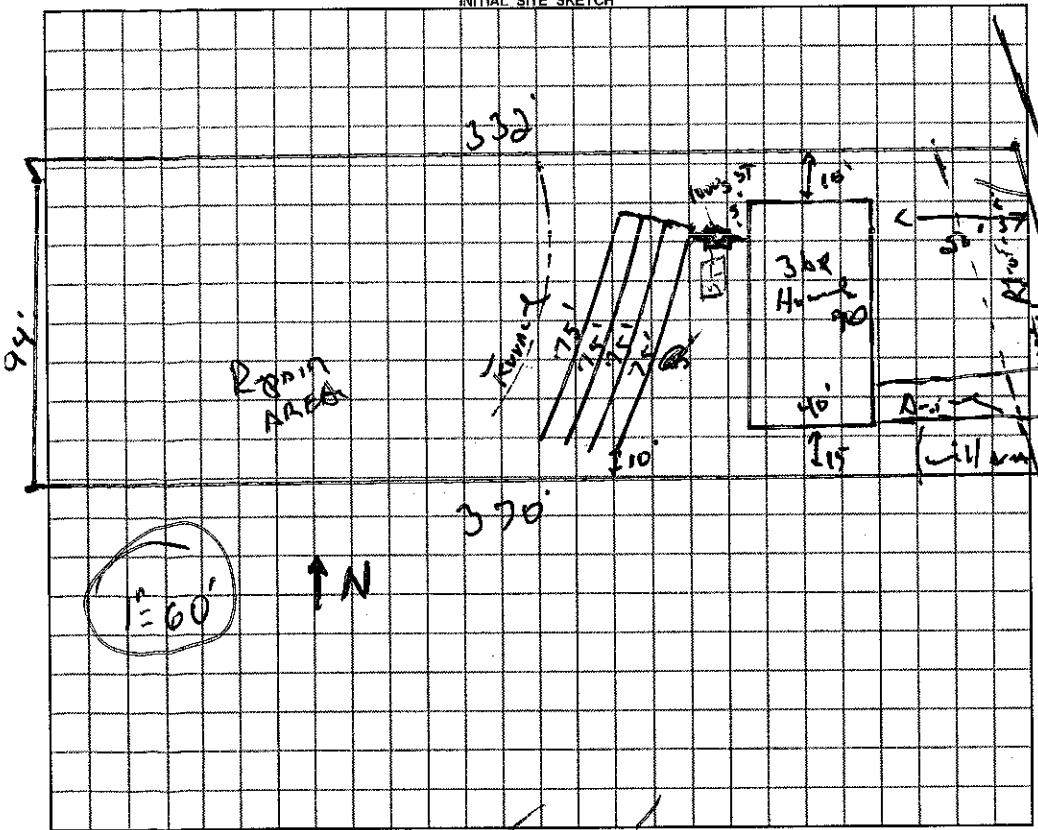

AS BUILT SKETCH

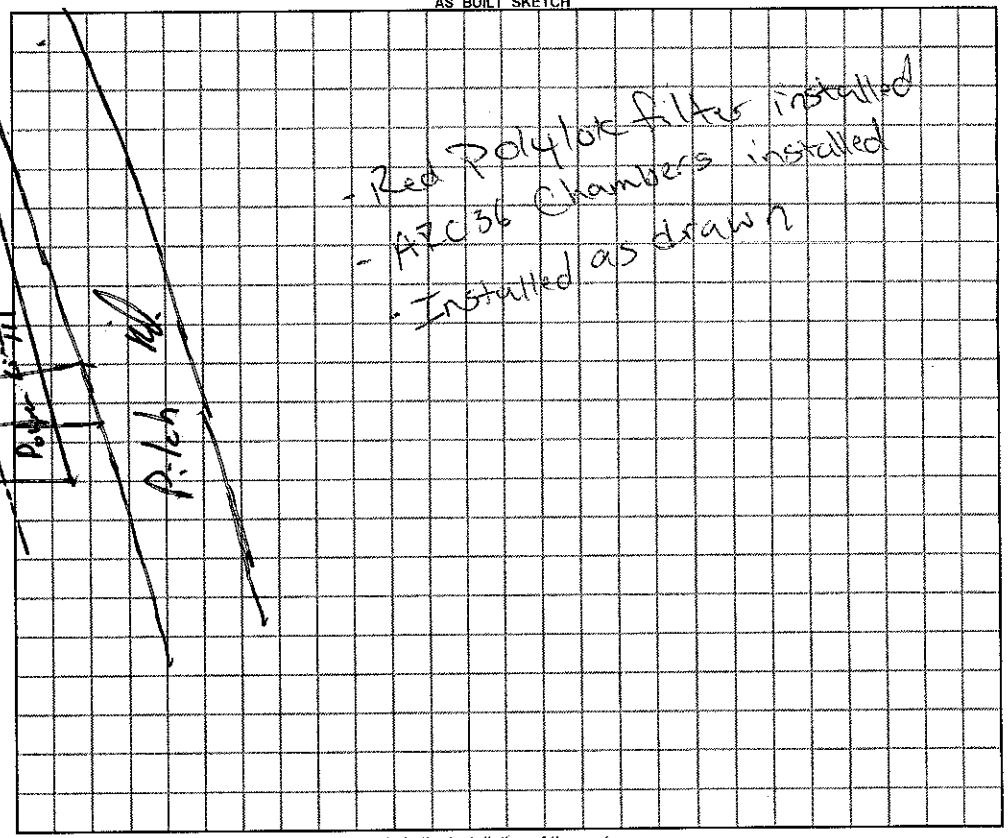

Permit can be suspended or revoked if any false information is supplied toward securing the permit / any unauthorized changes are made to the site / any unauthorized changes are made in the installation of the system.

☐ ***IMPROVEMENT PERMIT*** with plat valid without expiration. ☑ ***IMPROVEMENT PERMIT*** with plat ~~valid~~ site plan valid 60 mo. ☐ ***AUTHORIZATION TO CONSTRUCT*** valid for period equal to IMPROVEMENT PERMIT--not to exceed 60 mo.

Owner / Applicant Signature: Date 10/28/11 Installed by: Tim Abee

IMPROVEMENT PERMIT by: REHS Date 22 Sept. 11 OPERATION PERMIT by: Justin Henderson REHS Date 3-21-13

AUTHORIZATION TO CONSTRUCT by: R. Steve Hedrick REHS Date MAR 14, 2013 Existing System Inspected by: REHS Date

YOU SHOULD CONTACT A LOCATOR SERVICE PRIOR TO ANY EXCAVATION

White Copy – Environmental Health YELLOW COPY (Final) Owner / Applicant PINK COPY (Initial) Owner / Applicant