IREDELL COUNTY HEALTH DEPARTMENT - ENVIRONMENTAL HEALTH ☐ STATESVILLE OFFICE 704-878-5305 ☐ MOORESVILLE OFFICE 704-664-5281

IMPROVEMENT PERMIT / AUTHORIZATION TO CONSTRUCT / OPERATION PERMIT / EXISTING SYSTEM INSPECTION

PERMIT # 163939 PIN # 4751-22-3699 DATE 22 September 2011

OWNER Hayden Investments APPLICANT: Lane Harrell PHONE: Home/Cell # (704) 902-4659 Business #

SITE ADDRESS Ostwalt-Amity Rd. Troutman OWNER / APPLICANT ADDRESS

SITE DIRECTIONS Corner of Ostwalt Amity Rd. and Pitch Rd.

SUBDIVISION Sparrows Pass BLOCK / SECTION LOT # 5 LOT AREA 0.7 ac. DESIGN FLOW 360 gpd L.T.A.R. 0.3 gpd/ft²

Septic Tank 1000 Gallons: STB 760 Date 10-9-12

Pump Tank Gallons: P T Date

Pump Make Model Serial #

No. Nitrification Fields: 1 No. Lines 4 Linear Feet 300

Trench Width 36" Max. Trench Bottom Depth 36" Gravel Depth NA

☑ New System ☐ Repair ☐ Expansion System Type I II (III) IV V VI

System Description: 25% Reduction System

Repair System Description: 25% Reduction System.

Maintenance Agreement Required ☐ YES ☑ NO

☑ GRAVITY ☐ PRESSURE

☑ Residence No. Bedrooms 3

☐ Business No. Persons

☐ Other No. Employees


☐ Slab ☑ Crawl Space

☐ Basement w/plumbing ☐ Basement w/o plumbing


Water Supply: ☑ Private ☐ Public ☐ Community

Comments / Conditions Keep well 100' from system / Follow contours / Keep out of power line Rt-of-way.

INITIAL SITE SKETCH

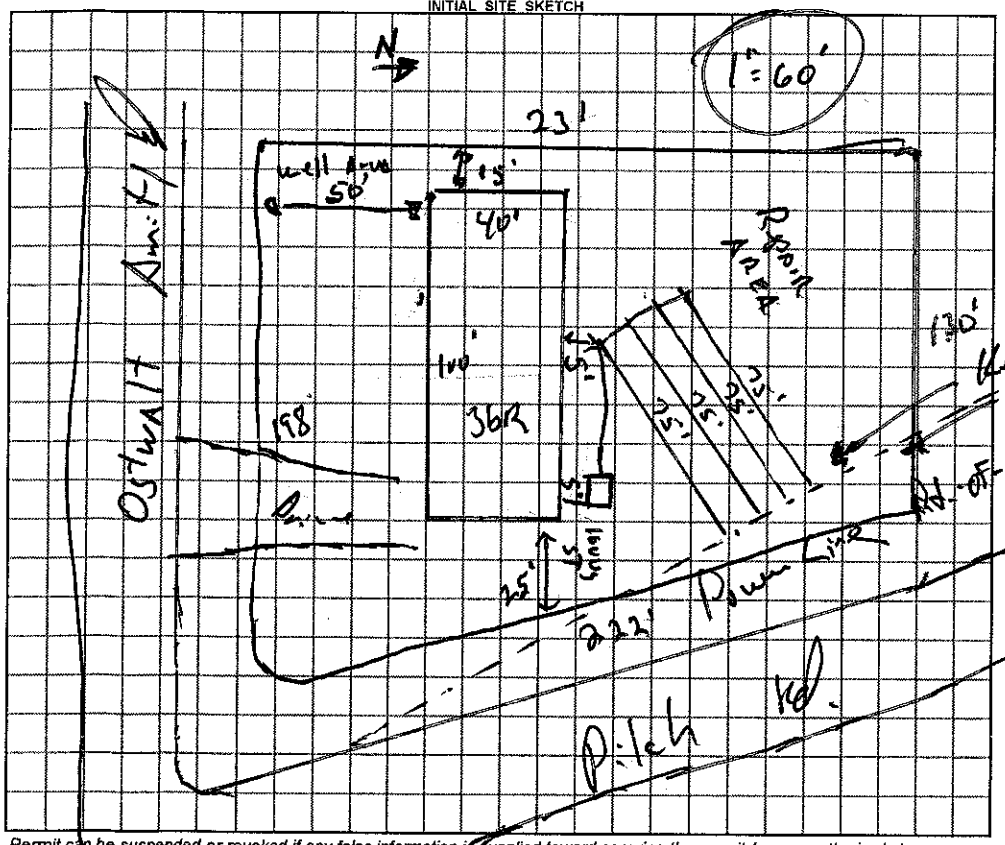

AS BUILT SKETCH

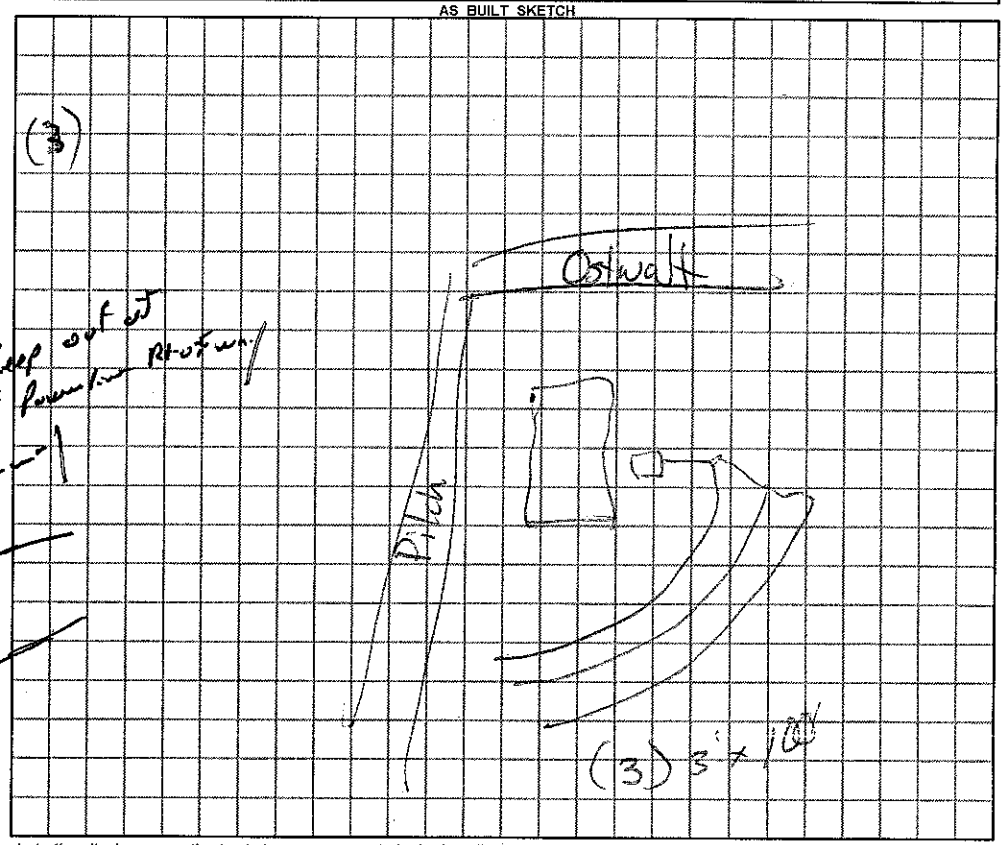

Permit can be suspended or revoked if any false information is supplied toward securing the permit / any unauthorized changes are made to the site / any unauthorized changes are made in the installation of the system.

☐ *IMPROVEMENT PERMIT* with plat valid without expiration. ☑ *IMPROVEMENT PERMIT* with plat valid for 60 mos. Site plan valid for mos. ☐ *AUTHORIZATION TO CONSTRUCT* valid for period equal to IMPROVEMENT PERMIT–not to exceed 60 mo.

Owner / Applicant Signature: 2-27-12 Date 10/29/11 Installed by: A-1 Backhoe

IMPROVEMENT PERMIT by: REHS Date 22 Sept. 11 OPERATION PERMIT by: REHS Date 3-13-12

AUTHORIZATION TO CONSTRUCT by: REHS Date 2-27-12 Existing System Inspected by: REHS Date

YOU SHOULD CONTACT A LOCATOR SERVICE PRIOR TO ANY EXCAVATION

White Copy – Environmental Health YELLOW COPY (Final) Owner / Applicant PINK COPY (Initial) Owner / Applicant