IREDELL COUNTY HEALTH DEPARTMENT - *ENVIRONMENTAL HEALTH* ☐ STATESVILLE OFFICE 704-878-5305 ☐ MOORESVILLE OFFICE 704-664-5281

IMPROVEMENT PERMIT / AUTHORIZATION TO CONSTRUCT / OPERATION PERMIT / EXISTING SYSTEM INSPECTION

PERMIT # 168758 PIN # 4751-23-2160 DATE 26 October 2011

OWNER Scottie Brown APPLICANT: PHONE: Home/Cell # (704) 309-5564 Business #

SITE ADDRESS 480 Pilch Rd. Troutman OWNER / APPLICANT ADDRESS


SITE DIRECTIONS Pilch Rd just before intersection of Ostwalt-Amity Rd.

SUBDIVISION Spanow's Pass BLOCK / SECTION LOT # 2 LOT AREA 0.73ac. DESIGN FLOW 240gpd L.T.A.R. 0.3/1.0

Septic Tank 1000g	Gallons: STB 1012	Date 7-29-11	☑ New System ☐ Repair ☐ Expansion System Type I II (III) IV V VI	☑ Residence	No. Bedrooms 2	Water Supply
Pump Tank	Gallons: P T	Date	System Description: 25% Reduction System	☐ Business	No. Persons	☑ Private
Pump Make	Model	Serial #	Repair System Description: 25% Reduction System	☐ Other	No. Employees	☐ Public
No. Nitrification Fields: 1	No. Lines 3	Linear Feet 200'	Maintenance Agreement Required ☐ YES ☑ NO	☐ Slab	☑ Crawl Space	☐ Community
Trench Width 36"	Max. Trench Bottom Depth 36"		Gravel Depth N/A ☑ GRAVITY ☐ PRESSURE	☐ Basement w/plumbing	☐ Basement w/o plumbing	

Comments / Conditions Keep 25' from drainage ditch. * Water from adjacent property.

INITIAL SITE SKETCH

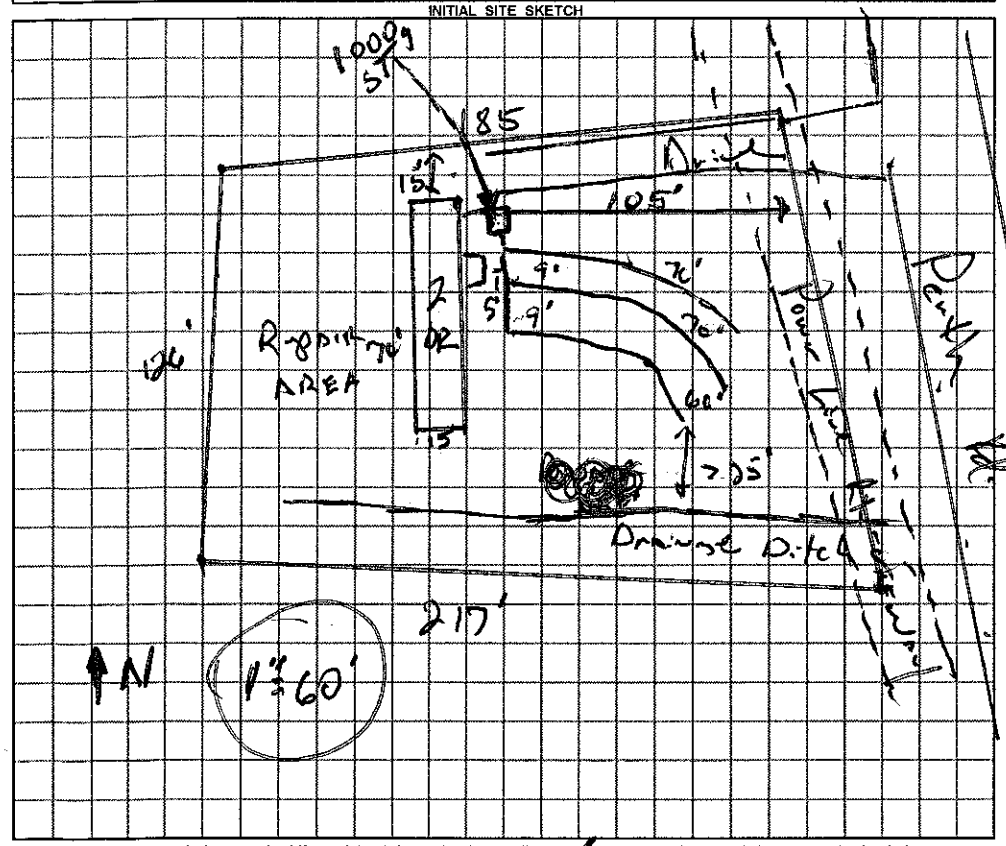

AS BUILT SKETCH

Permit can be suspended or revoked if any false information is supplied toward securing the permit / any unauthorized changes are made to the site / any unauthorized changes are made in the installation of the system.

☐ ***IMPROVEMENT PERMIT*** with plat valid without expiration. ☑ ***IMPROVEMENT PERMIT*** with ~~plat valid without expiration.~~ site plan valid 60 mo. ☑ ***AUTHORIZATION TO CONSTRUCT*** valid for period equal to IMPROVEMENT PERMIT--not to exceed 60 mo.

Owner / Applicant Signature: Date 10-27-11 Installed by: Kenny Dollar Madison

IMPROVEMENT PERMIT by: REHS Date 26 Oct 2011 OPERATION PERMIT by: REHS Date 31 Oct. 11

AUTHORIZATION TO CONSTRUCT by: REHS Date 26 Oct. 2011 Existing System Inspected by: REHS Date

YOU SHOULD CONTACT A LOCATOR SERVICE PRIOR TO ANY EXCAVATION

White Copy – Environmental Health YELLOW COPY (Final) Owner / Applicant PINK COPY (Initial) Owner / Applicant