IREDELL COUNTY HEALTH DEPARTMENT

Statesville Office (704) 878-5305 Mooresville Office (704) 660-3625 PERMIT # 213503

IMPROVEMENT PERMIT / AUTHORIZATION TO CONSTRUCT / OPERATION PERMIT / EXISTING SYSTEM

PIN # 4751 240700

APPLICANT: Jan Pizutto APPLICANT ADDRESS: 206 Riverwalk Rd, Stony Point NC

SITE ADDRESS: 404 Pilch Rd Troutman NC PHONE: 704-402-0463 ALT. PHONE: 704-402-0395

SITE DIRECTIONS: 215 T/L Oswalt Amity Rd T/L Pilch Rd House on left


SUBDIVISION: N/A SECTION: N/A LOT # N/A LOT AREA: 1 ac DESIGN FLOW: 240 L.T.A.R.: Ey

Septic Tank	Ey	(gal)	STB		Date		☐ New System	☐ Repair	☐ Expansion	System Type: I	☒ II	III IV V VI	☒ Residence	No. Bedrooms	2	Water Supply
Pump Tank		(gal)	PT		Date		System Description:	Existing					☐ Business	No. Persons	4	☒ Private
Pump Make		Model			Serial #		Repair System Description:						☐ Other	No. Employees		☐ Public
# Nitrification Fields	Ey	# Lines	Ey		Linear Ft:	Ey	Maintenance Agreement Required:	☐ YES	☒ NO				☐ Slab	☒ Crawl Space		☐ Community
Trench Width	Ey	Max. Trench Bottom Depth		Ey	Gravel Depth	Ey		☒ GRAVITY	☐ PRESSURE				☐ Basement w/plumbing		☐ Basement w/o plumbing	

Comments / Conditions: All building foundations must be 55' from any part of STS and 525' from any well

INITIAL SITE SKETCH

AS BUILT SKETCH

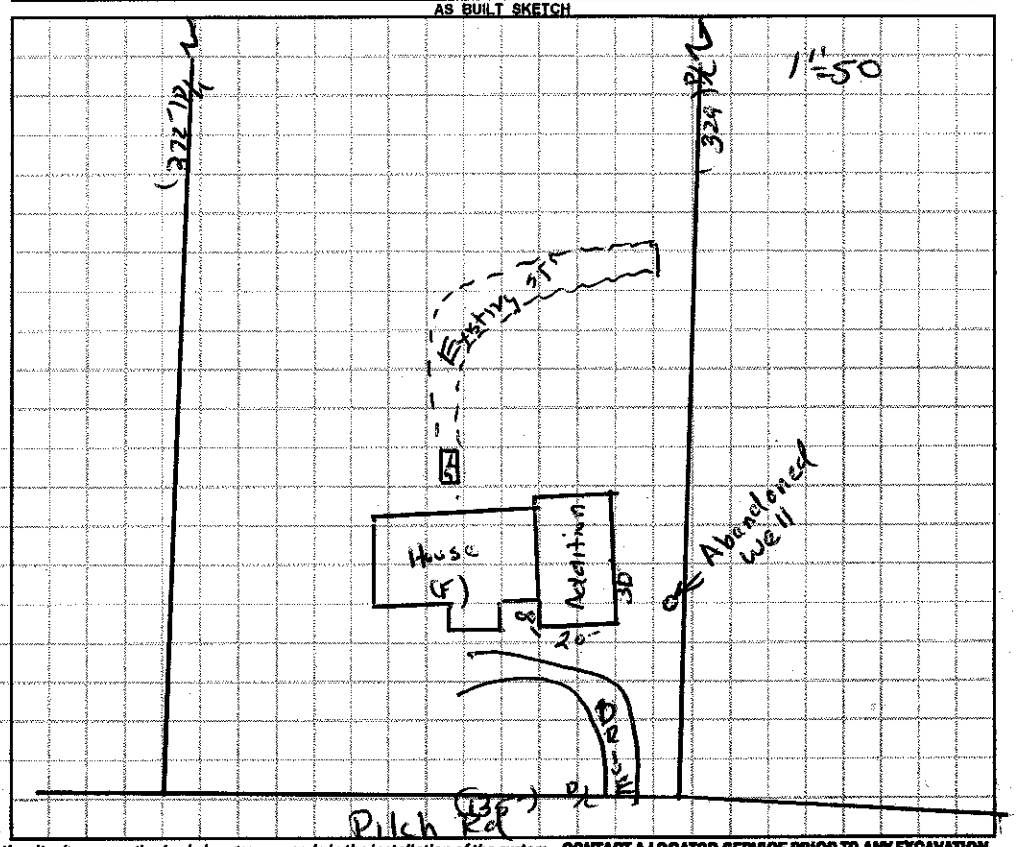

Permit can be suspended or revoked if any false information is supplied toward securing the permit / any unauthorized changes are made to the site / any unauthorized changes are made in the installation of the system. **CONTACT A LOCATOR SERVICE PRIOR TO ANY EXCAVATION**

☐ **IMPROVEMENT PERMIT** *with plat valid without expiration.* ☐ **IMPROVEMENT PERMIT** *with site plan valid for 60 mos.* ☐ **AUTHORIZATION TO CONSTRUCT** *valid for period equal to IMPROVEMENT PERMIT--not to exceed 60 mo.*

Owner / Applicant Signature: Jan Pizutto Date: 4/27/16 Installed by:

IMPROVEMENT PERMIT by: Date: OPERATION PERMIT by: Date:

AUTHORIZATION TO CONSTRUCT by: Date: Existing System Inspected by: Date: 03/21/16

Health Dept. Copy - WHITE Applicant (Final Approval) - YELLOW Applicant (Conditional Approval) - PINK