IREDELL COUNTY HEALTH DEPARTMENT

STATESVILLE 704-878-5305 MOORESVILLE 704-664-5281

IMPROVEMENT PERMIT / AUTHORIZATION TO CONSTRUCT / OPERATION PERMIT / EXISTING SYSTEM INSPECTION

PERMIT# REPAIR PIN# 4751-25-0397 DATE 6-7-04

OWNER OR CONTRACTOR ASHLEY NEIL PYLER PHONE: Business 704-902-1968 Home

ADDRESS 380 PILGH ROAD, TROUTMAN NC 28166

LOCATION I-77 SOUTH, TL AMITY HILL ROAD, TR PILGH ROAD, ON RIGHT 3RD LOT PAST REAR TREE @ 380

SUBDIVISION BLOCK / SECTION LOT 1 LOT AREA 0.53 ACRE SITE CLASS: PS DESIGN FLOW 360 L.T.A.R. EXISTING (0.35 SQ FT)

Septic Tank: EXISTING Gallons: STB 794 Date 5-4-94
Pump Tank: Gallons: PT Date
Pump Make: Model Serial No.
Nitrification Field: No Fields 1 Square Feet 270 Linear Feet 90
No Lines 1 Trench Width 36" Max Trench Bottom Depth 36"

☐ New System ☑ Repair System Type: I, II, III, IV, V, VI
System Description:
Repair System Description: CONVENTIONAL, GRAVITY
Maintenance Agreement Required: ☐ Yes ☑ No

Gravel Depth 24" ☐ Slab ☑ Crawl Space ☐ Basement w/plumbing ☐ Basement wo/plumbing


☐ House/Mod. Home No. Bedrooms 3
☑ Mobile Home No. Bathrooms 2
☐ Business No. Employees
☐ Other

Water Supply: ☑ Individual ☐ Public ☐ Community
WELL NEAR DOOR


Comments:/Conditions: ① INTERCEPT EXISTING DRAINLINE AT LOCATION SHOWN WITH NEW 3' x 90' DRAINLINE USING 24" STONE. ② THIS PERMIT SERVES AS "NOTICE OF VIOLATION" SYSTEM TO BE REPAIRED BY July 7, 2004

Comments:/Conditions:

INITIAL SITE SKETCH

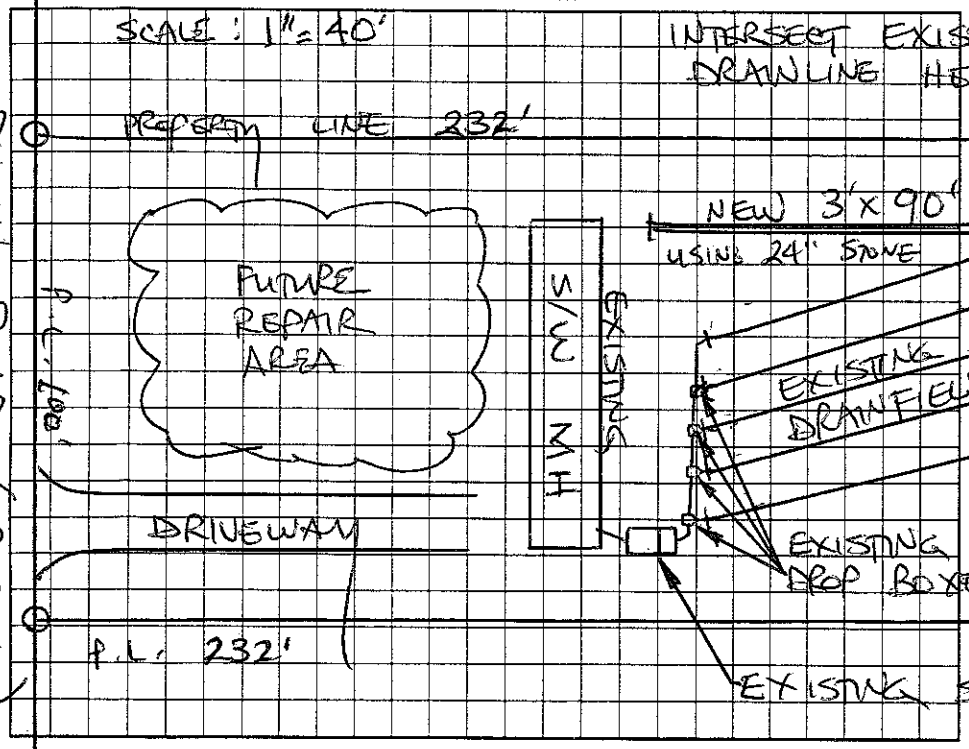

AS BUILT SKETCH

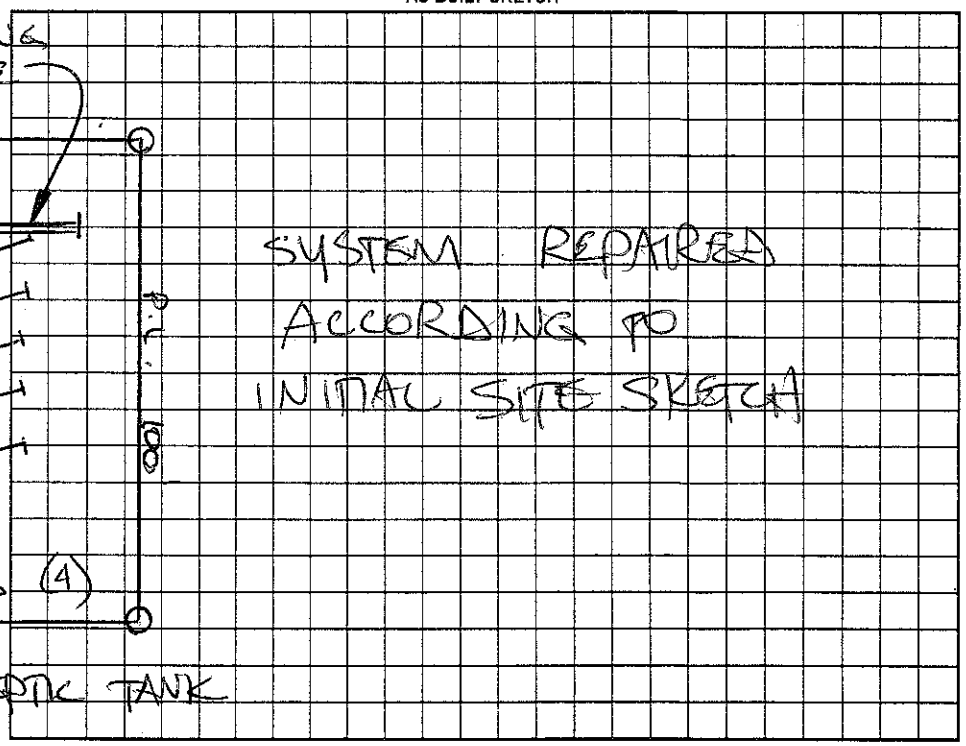

Permit can be suspended or revoked if any false information is supplied toward securing the permit/any unauthorized changes are made to the site/any unauthorized changes are made in the installation of the system. Improvement Permit with plat valid without expiration. Improvement Permit with site plan valid for sixty months. Authorization to Construct is valid for a period equal to that of Improvement Permit – not to exceed sixty months.

Signed: [signature] date 6-7-04

Improvement Permit by: STEVE HEDRICK date 6-7-04

Authorization to Construct by: STEVE HEDRICK date 6-7-04

Installed by: MARK TUCKER

Operation Permit by: STEVE HEDRICK date 7-14-04

Existing System Inspection by: date

HEALTH DEPT. COPY: WHITE OWNER COPY (FINAL): YELLOW OWNER COPY (INITIAL): PINK