IREDELL COUNTY HEALTH DEPARTMENT

STATESVILLE 704-878-5305 MOORESVILLE 704-664-5281

IMPROVEMENT PERMIT / AUTHORIZATION TO CONSTRUCT / OPERATION PERMIT / EXISTING SYSTEM INSPECTION

PERMIT# 146464 PIN# 4751-26 ~~4478~~ 50874 DATE 11-14-2007

OWNER OR APPLICANT MIKE FAULKENBERRY PHONE: Business 704-201-6465 Home 631-774-8864

ADDRESS 217 CAMP ROAD, MOORESVILLE, NC 28117

LOCATION US21 S, TL AMITY HILL RD, TR PILCH ROAD TR AT PEAR TREE, 2ND LOT ON LEFT (WINDSPAR)

SUBDIVISION PARAMOUNT WOODS BLOCK / SECTION ____ LOT 2 LOT AREA ~27,000 SF SITE CLASS. PS DESIGN FLOW 360 L.T.A.R. 0.30 GPD/FT²

Septic Tank: 1000 Gallons; STB 1012 Date 5-9-07

Pump Tank: ~~1000~~ Gallons; PT ____ Date ____

Pump Make: ____ Model ____ Serial No. ____

Nitrification Field: No Fields 1 Square Feet 1200 Linear Feet 300

No Lines FOUR Trench Width 36" Max Trench Bottom Depth 34"

☒ New System ☐ Repair ☐ Expansion System Type: I II III IV V VI

System Description: 25% REDUCTION

Repair System Description: 25% REDUCTION LOW PRESSURE

Maintenance Agreement Required: ☐ Yes ☒ No

Gravel Depth N/A ☐ Gravity ☒ Pressure

☒ House/Mod. Home ☐ Mobile Home ☐ Business ☐ Other

No. Bedrooms 3 No. Persons ____ No. Employees ____

Water Supply: ☒ Individual ☐ Public ☐ Community WELL

☐ Slab ☐ Crawl Space ☐ Basement w/plumbing ☐ Basement wo/plumbing

Comments:/Conditions:

Comments:/Conditions:


* Last line 36"
* Gravity System

INITIAL SITE SKETCH

SEE ATTACHED "FAST TRACK" SITE PLAN PREPARED BY MICHAEL ATHANAS & ASSOC., INC

AS BUILT SKETCH

Yellow Lot Lot
Septic Area

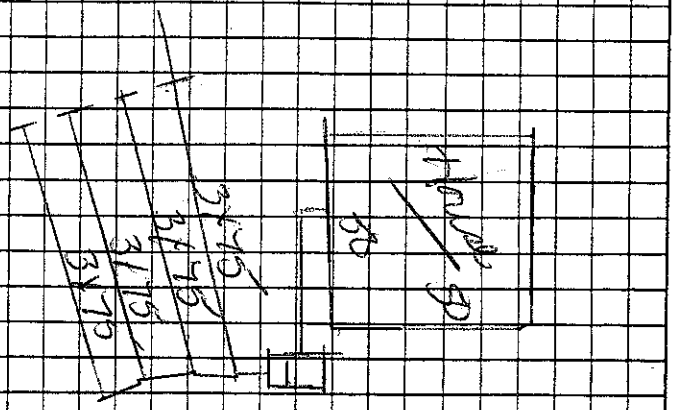


Permit can be suspended or revoked if any false information is supplied toward securing the permit/any unauthorized changes are made to the site/any unauthorized changes are made in the installation of the system. Improvement Permit with plat valid without expiration ☐ Improvement Permit with site plan valid for sixty months ☒ Authorization to Construct is valid for a period equal to that of Improvement Permit – not to exceed sixty months.

Signed: [signature] date 11-15-07 Installed by: C & S Grading

Improvement Permit by: STEVE HEDRICK date 11-14-2007 Operation Permit by: [signature] date 1-16-08

Authorization to Construct by: STEVE HEDRICK date 11-14-2007 Existing System Inspection by: ____ date ____

HEALTH DEPT. COPY: WHITE OWNER COPY (FINAL): YELLOW OWNER COPY (INITIAL): PINK

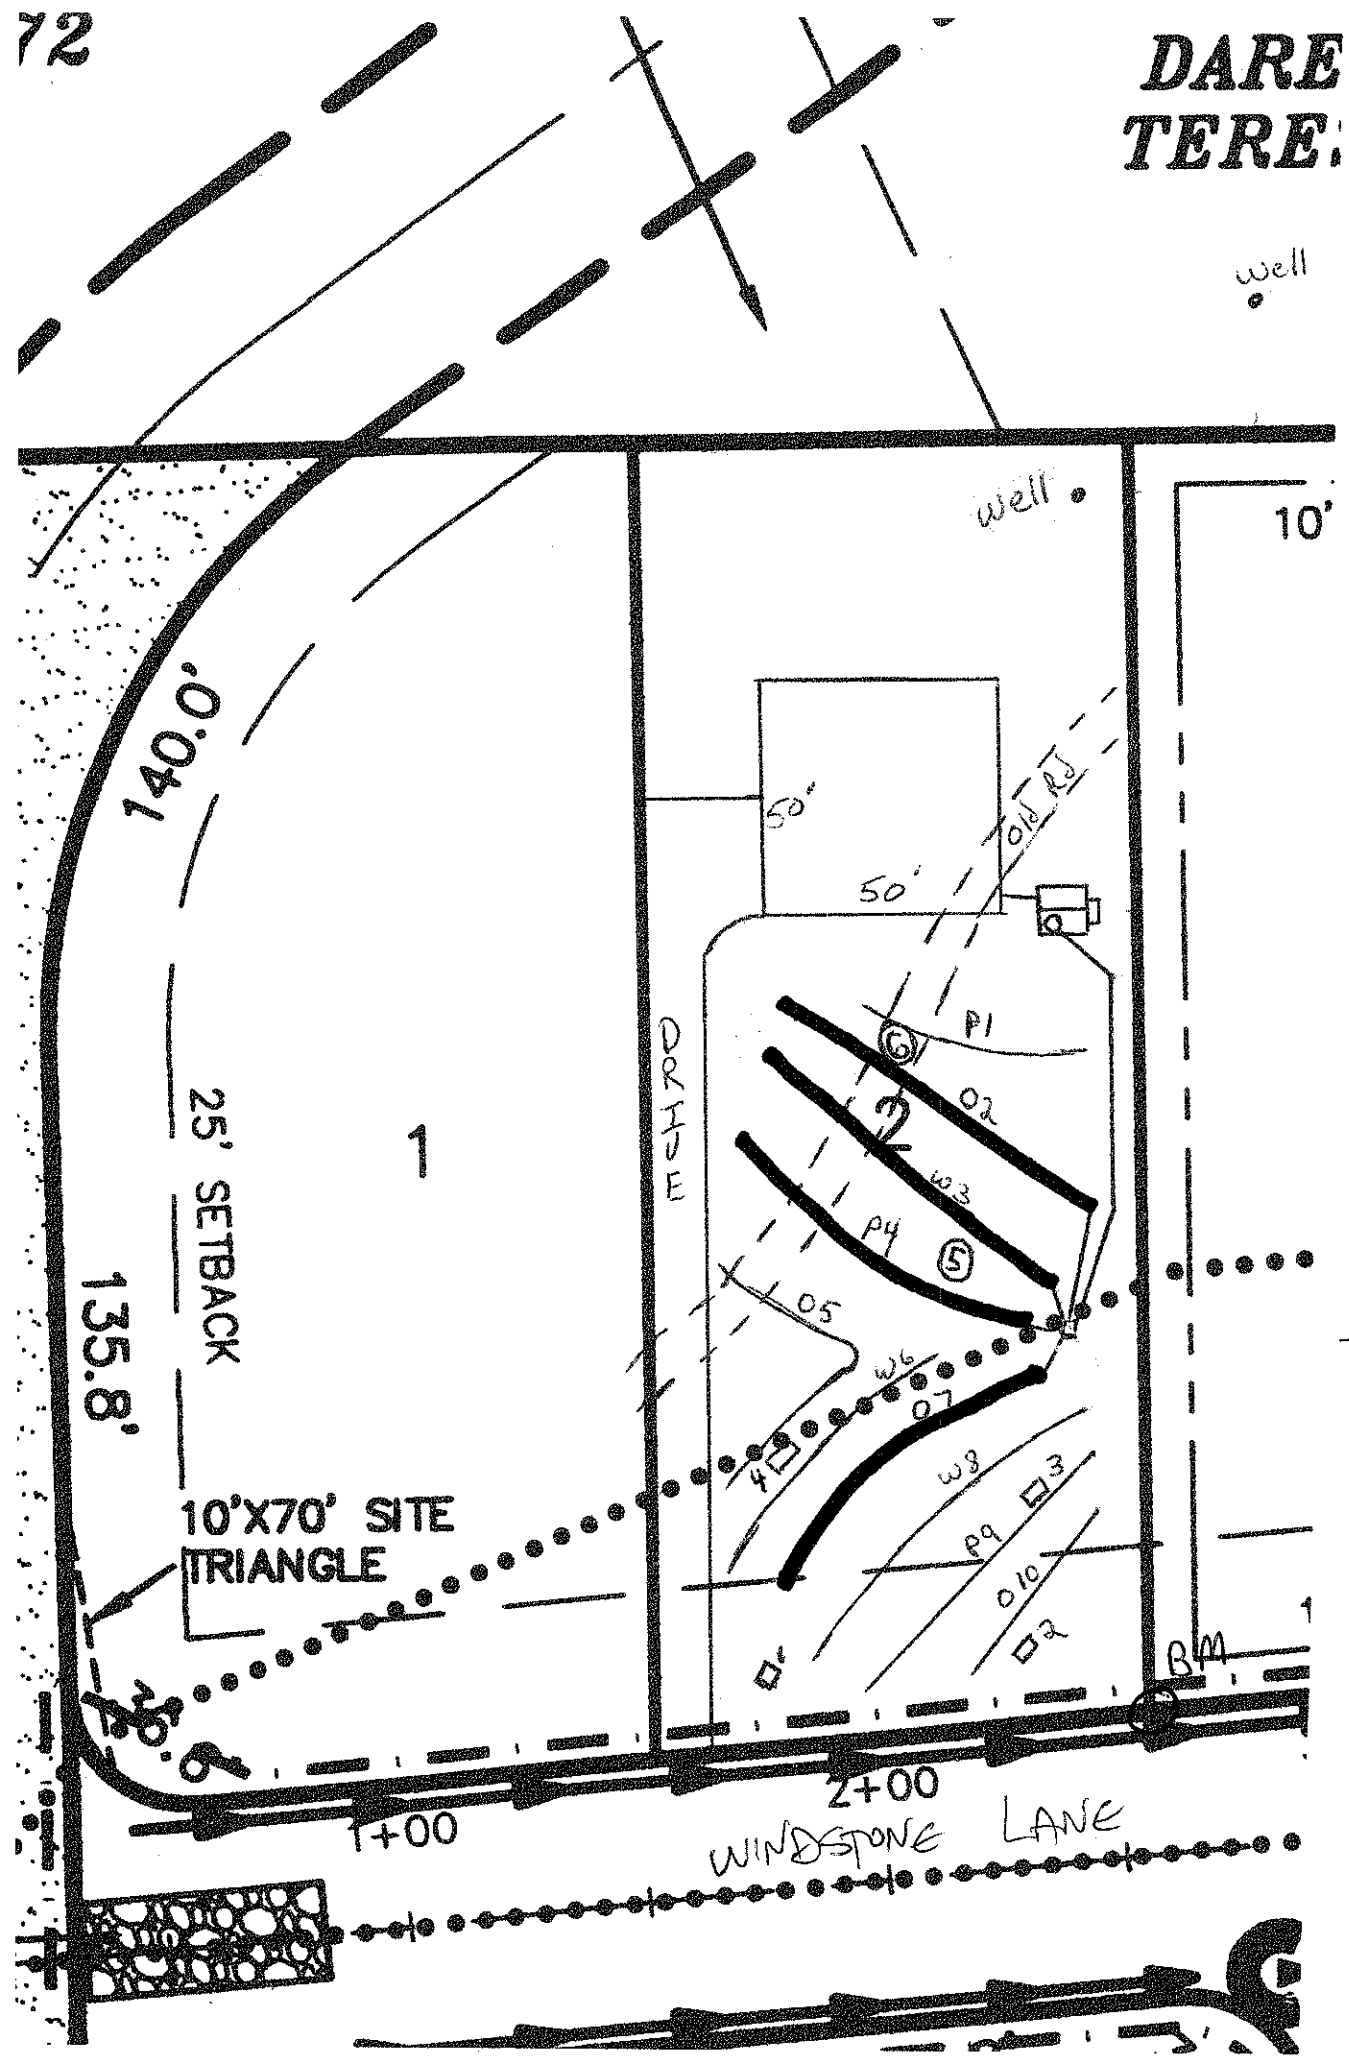
72
DARE
TERE
well
well
10'
140.0'
50'
50'
Old RJ
DRIVE
P1
02
w3
P4
05
w6
07
w8
P9
010
25' SETBACK
135.8'
1
2
10'X70' SITE TRIANGLE
1+00
2+00
WINDSTONE LANE
N
Scale
1"=40'