IREDELL COUNTY HEALTH DEPARTMENT

STATESVILLE 704-878-5305 MOORESVILLE 704-664-5281

IMPROVEMENT PERMIT / AUTHORIZATION TO CONSTRUCT / OPERATION PERMIT / EXISTING SYSTEM INSPECTION

PERMIT # REPAIR PIN # 4751-28-3626 DATE MARCH 20 2012

OWNER or APPLICANT CHRISTINE A. STEDMAN PHONE: Business Home: 704-657-9362

OWNER or APPLICANT ADDRESS 168 DUSTY LOOP / 215 SUMMERTREE DR, TROUTMAN, NC, 28166-8787

LOCATION / DIRECTIONS AMITY HILL ROAD TO MOUNTAINEER DR, TR DUSTY LOOP (2ND) 1ST ON LEFT


SUBDIVISION OLDE TOWN MH INC BLOCK / SECTION LOT # 19 LOT AREA ~1 ACRE DESIGN FLOW 360 L.T.A.R. 0.4 (EXIST)

Septic Tank EXISTING	Gallons: STB	Date	☐ New System ☑ Repair ☐ Expansion System Type I II III IV V VI	☑ Residence	No. Bedrooms 3	Water Supply
Pump Tank	Gallons: PT	Date	System Description:	☐ Business	No. Persons	☑ Private
Pump Make	Model	Serial #	Repair System Description: CONV. GRAVITY	☐ Other	No. Employees	☐ Public WELL
Nitrification Field No. Fields 1	No. Lines 4	Linear Feet 300 (EX)	Maintenance Agreement Required ☐ YES ☑ NO	☐ Slab	☑ Crawl Space	☐ Community
Trench Width EX	Max. Trench Bottom Depth EX	Gravel Depth 12"	☑ GRAVITY ☐ PRESSURE	☐ Basement w/plumbing	☐ Basement w/o plumbing	

Comments / Conditions: REPLACE EXISTING DISTRIBUTION BOX WITH TWO (2) NEW DROP BOXES TO ACHIEVE SERIAL DISTRIBUTION. FEED LINES TO LEFT (FROM STREET) FIRST USING SAGD LEVELERS.

Comments / Conditions

INITIAL SITE SKETCH

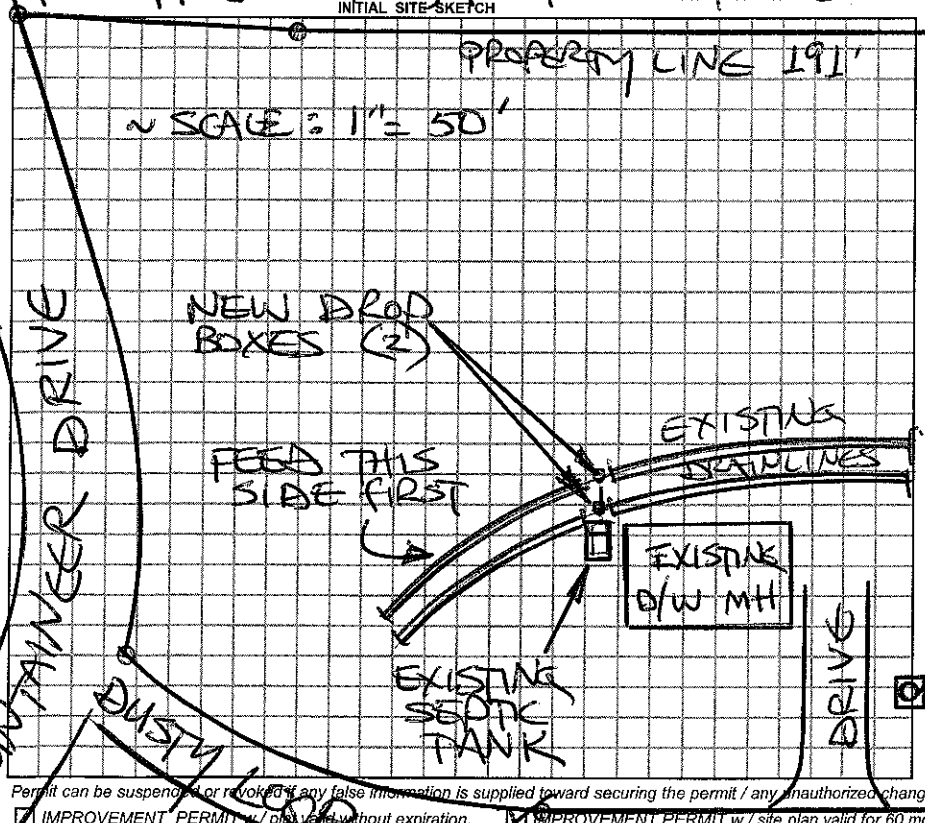

AS BUILT SKETCH

SYSTEM REPAIRED ACCORDING TO INITAL SITE SKETCH

Permit can be suspended or revoked if any false information is supplied toward securing the permit / any unauthorized changes are made to the site / any unauthorized changes are made in the installation of the system.

☑ *IMPROVEMENT PERMIT w / plan valid without expiration.* ☑ *IMPROVEMENT PERMIT w / site plan valid for 60 mos.* ☑ *AUTHORIZATION TO CONSTRUCT valid for period equal to IMPROVEMENT PERMIT-not to exceed 60 mo.*

Owner / Applicant Signature: Date 3/21/12

Improvement Permit by: STEVE HEDRICK Date 3/20/12

Authorzation to Construct by: STEVE HEDRICK Date 3/20/12

YOU SHOULD CONTACT A LOCATOR SERVICE PRIOR TO ANY EXCAVATION!

Installed by: JARED LENTZ

Operation Permit by: STEVE HEDRICK Date: 10/17/12

Existing System Inspected by: Date:

WHITE COPY Environmental Health YELLOW COPY (Final) Owner / Applicant PINK COPY (Initial) Owner / Applicant