1130

IREDELL COUNTY HEALTH DEPARTMENT - *ENVIRONMENTAL HEALTH* ☒ STATESVILLE OFFICE 704-878-5305 ☐ MOORESVILLE OFFICE 704-664-5281

IMPROVEMENT PERMIT / AUTHORIZATION TO CONSTRUCT (01) / OPERATION PERMIT (01) / EXISTING SYSTEM INSPECTION

PERMIT # 170922 PIN # 4751-29-6625.001 DATE 3-12-12

OWNER Timothy + Joseph Lay APPLICANT: PHONE: Home/Cell # 704-491-2693 Business #

SITE ADDRESS 3202 Amity Hill Rd OWNER / APPLICANT ADDRESS

SITE DIRECTIONS 77S, (L) @ exit 45 on Amity Hill Rd, go 1 mi +/- site across from # 3205

SUBDIVISION n/a BLOCK / SECTION n/a LOT # LOT AREA .8352 DESIGN FLOW 360 L.T.A.R. .25

Septic Tank 1000 Gallons: STB 794 Date 11-21-11 ☒ New System ☐ Repair ☐ Expansion System Type I II (III) IV V VI

Pump Tank Gallons: P T Date System Description: 25% Reduction Gravity

Pump Make Model Serial # Repair System Description: 25% Reduction Gravity

No. Nitrification Fields: 1 No. Lines 4 Linear Feet 360 Maintenance Agreement Required ☐ YES ☒ NO


Trench Width 36" Max. Trench Bottom Depth 36" Gravel Depth n/a ☒ GRAVITY ☐ PRESSURE

☒ Residence No. Bedrooms 3 ☐ Business No. Persons ☐ Other No. Employees ☐ Slab ☒ Crawl Space ☐ Basement w/plumbing ☐ Basement w/o plumbing


Water Supply: ☒ Private ☐ Public ☐ Community

Comments / Conditions

INITIAL SITE SKETCH

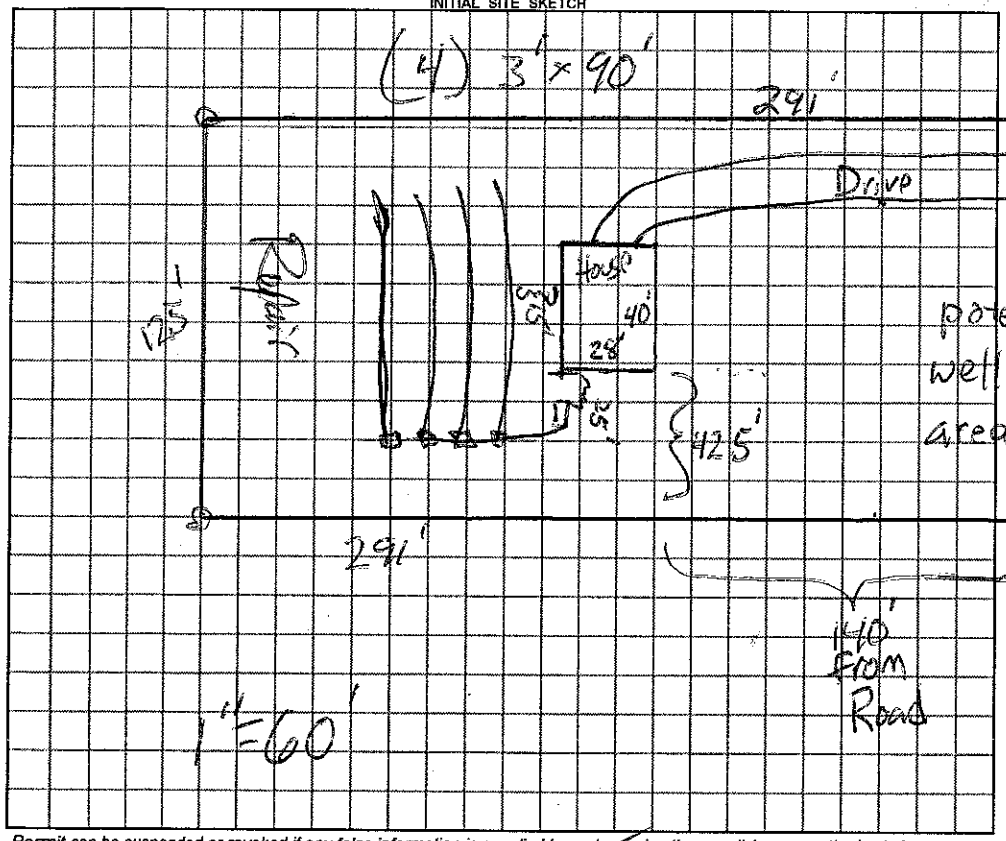

AS BUILT SKETCH

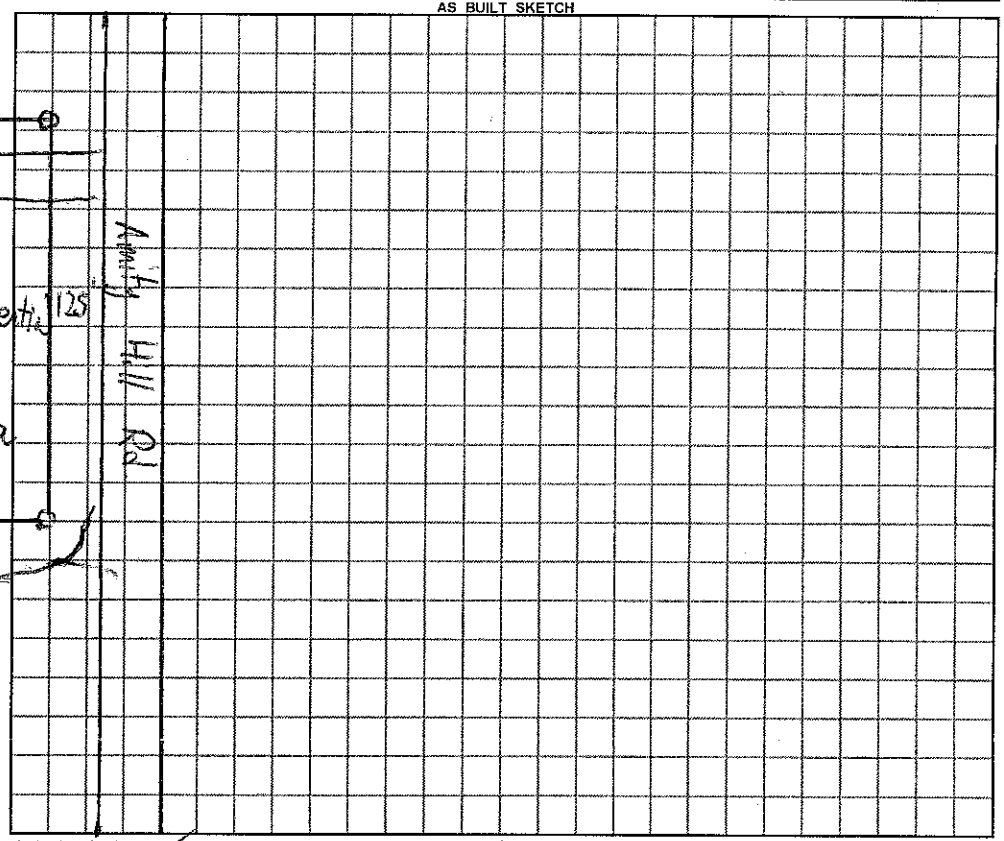

Permit can be suspended or revoked if any false information is supplied toward securing the permit / any unauthorized changes are made to the site / any unauthorized changes are made in the installation of the system.

☐ ***IMPROVEMENT PERMIT*** *with plat valid without expiration.* ☒ ***IMPROVEMENT PERMIT*** *with plat valid without expiration. site plan valid 60 mo.* ☒ ***AUTHORIZATION TO CONSTRUCT*** valid for period equal to IMPROVEMENT PERMIT--not to exceed 60 mo.

Owner / Applicant Signature: Date 3/14/12 Installed by: Huddler

IMPROVEMENT PERMIT by: REHS Date 3-12-12 OPERATION PERMIT by: REHS Date 3-19-12

AUTHORIZATION TO CONSTRUCT by: REHS Date 3-12-12 Existing System Inspected by: REHS Date

YOU SHOULD CONTACT A LOCATOR SERVICE PRIOR TO ANY EXCAVATION

White Copy – Environmental Health YELLOW COPY (Final) Owner / Applicant PINK COPY (Initial) Owner / Applicant