IREDELL COUNTY HEALTH DEPARTMENT

STATESVILLE 704-878-5305 MOORESVILLE 704-664-5281

IMPROVEMENT PERMIT / CERTIFICATE OF COMPLETION / OPERATION PERMIT / EXISTING SYSTEM INSPECTION

PROPERTY DESCRIPTION NO. 19531 DATE 10/13/94 TAX MAP NO. 4L - 3A - 11

OWNER OR CONTRACTOR Salim K Hamzah Watershed: ☐ Yes ☐ ~~No~~

ADDRESS Kissimmee, Fla. PHONE: Business Home 407 - 892 - 4959

LOCATION Summertree Dr. (L) off Rainwood, 1st lot on (R) 4751301355

SUBDIVISION Summertree BLOCK / SECTION LOT 11 LOT AREA .776 SITE CLASS. P DESIGN FLOW 360 L.T.A.R. .3

Septic Tank: 1000 Gallons; STB 794 Date 10/17/94

Pump Tank: Gallons; PT Date

Pump Make: Model Serial No.

Nitrification Field: No Fields 1 Square Feet 1200 Linear Feet 400

No Lines 4 Trench Width 36" Max Trench Bottom Depth 32" Gravel Depth 12"

☑ New System ☐ Repair System Type: I, (II), III, IV, V, VI

System Description: CONVENTIONAL

Repair System Description:

Maintenance Agreement Required: ☐ Yes ☑ ~~No~~

☑ ~~House/Mod. Home~~ D/W No. Bedrooms 3

☐ Mobile Home No. Bathrooms 2

☐ Business No. Employees

☐ Other


☐ Slab ☑ ~~Crawl Space~~ ☐ Basement w/plumbing ☐ Basement wo/plumbing

Water Supply: ☑ ~~Individual~~ ☐ Community ☐ Public

Comments: TIGHT - Do not change without Health Dept. approval.

Comments: Installed as shown on Imp. Permit

INITIAL SITE SKETCH FENCE

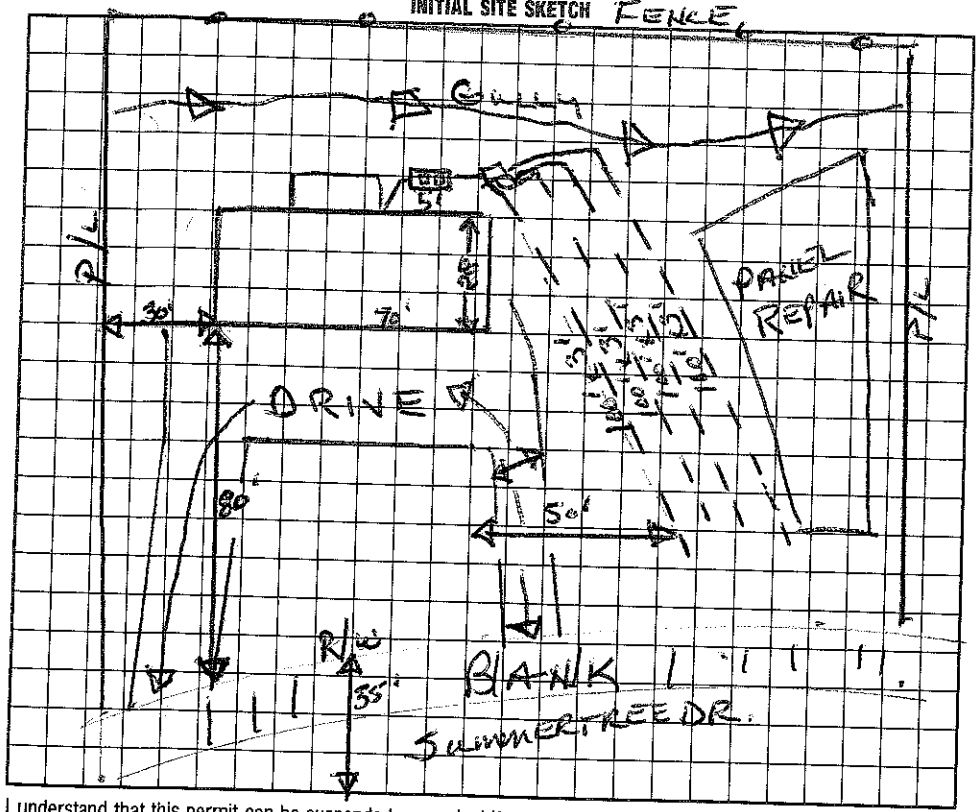

AS BUILT SKETCH

I understand that this permit can be suspended or revoked if any false information is supplied toward securing the permit/any unauthorized changes are made to the site/any unauthorized changes are made in the installation of the system. Improvement Permit is valid for 60 months from date of issuance.

Signed: Salim K. Hamzah

Improvement Permit by: Wesley Sparks R.S. date 10/13/94

Existing System Inspection by: date

Installed by: Wes Lytton

Certificate of Completion by: Wesley Sparks R.S. date 12/20/94

Operation Permit by: date

HEALTH DEPT. COPY: WHITE INSPECTION COPY (FINAL): GREEN OWNER COPY (FINAL): YELLOW INSPECTION COPY (INITIAL): PINK OWNER COPY (INITIAL): GOLD