4751302449

IREDELL COUNTY HEALTH DEPARTMENT

STATESVILLE 704-878-5305 MOORESVILLE 704-664-5281

IMPROVEMENT PERMIT / CERTIFICATE OF COMPLETION / OPERATION PERMIT / EXISTING SYSTEM INSPECTION

PROPERTY DESCRIPTION NO. 13593 DATE 10/7/94 TAX MAP NO. 4L 3 A 10 Watershed: ☐ Yes ☒ No

OWNER OR CONTRACTOR Joan Campo PHONE: Business _____ Home 704-892-6914

ADDRESS 665 Lofton Ridge Dr. Winston Salem, NC 27104

LOCATION Summertree Dr. On Cul-de-sac TR Franklinwoods TR Ramwood TR Summertree on (R)

SUBDIVISION Summertree BLOCK / SECTION _____ LOT 10 LOT AREA +/- .78Ac SITE CLASS. P DESIGN FLOW 360 L.T.A.R. .4

Septic Tank: 1000 Gallons; STB 1012 Date 7/18/94

Pump Tank: _____ Gallons; PT _____ Date _____

Pump Make: _____ Model _____ Serial No. _____

Nitrification Field: No Fields 1 Square Feet 900 Linear Feet 300

No Lines 3 Trench Width 36" Max Trench Bottom Depth 36" Gravel Depth 12"

☒ New System ☐ Repair System Type: I, II, III, IV, V, VI

System Description: CONV - DIST BOX

Repair System Description: CONV.

Maintenance Agreement Required: ☐ Yes ☒ No

☐ House/Mod. Home No. Bedrooms 3

☒ Mobile Home No. Bathrooms 2

☐ Business No. Employees _____

☐ Other _____

☐ Slab ☐ Crawl Space ☐ Basement w/plumbing ☐ Basement wo/plumbing


Water Supply:
☒ Individual
☐ Community
☐ Public
PROPOSED

Comments:

INITIAL SITE SKETCH

Comments:

AS BUILT SKETCH

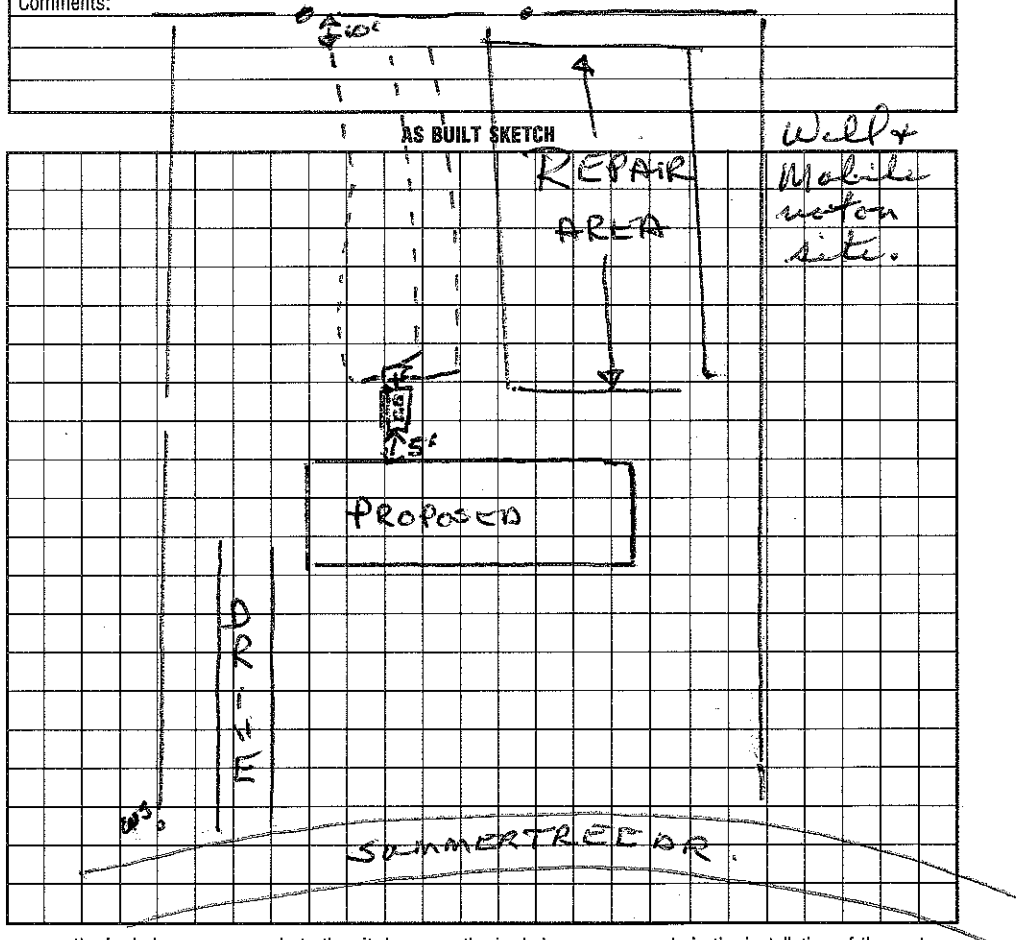

I understand that this permit can be suspended or revoked if any false information is supplied toward securing the permit/any unauthorized changes are made to the site/any unauthorized changes are made in the installation of the system. Improvement Permit is valid for 60 months from date of issuance.

Signed: _____

Improvement Permit by: _____ date _____

Existing System Inspection by: _____ date _____

Installed by: Cothern Backhoe + Pool Service

Certificate of Completion by: Wesley Sparks R.S. date 10/7/94

Operation Permit by: _____ date _____

HEALTH DEPT. COPY: WHITE INSPECTION COPY (FINAL): GREEN OWNER COPY (FINAL): YELLOW INSPECTION COPY (INITIAL): PINK OWNER COPY (INITIAL): GOLD