IREDELL COUNTY HEALTH DEPARTMENT

STATESVILLE 704-878-5305 | MOORESVILLE 704-664-5281

4751303635

IMPROVEMENT PERMIT / CERTIFICATE OF COMPLETION / OPERATION PERMIT / EXISTING SYSTEM INSPECTION

PROPERTY DESCRIPTION NO. 20525 DATE 4/24/95 TAX MAP NO. 4L 3 A 9

OWNER OR CONTRACTOR Dana Beatty PHONE: Business _____ Watershed: ☐ Yes ☑ No

ADDRESS 223 W Hwy 64 Mooresville, NC. 28115 Home 664-7860

LOCATION Summerlea D. Iredell County (R) Franklinwoods (L) at top 300 lot on (R)

SUBDIVISION Summerlea BLOCK / SECTION _____ LOT 9 LOT AREA ~ SITE CLASS. _____ DESIGN FLOW _____ L.T.A.R. _____

Septic Tank: 1000 Gallons; STB 824 Date 3-18-95

Pump Tank: _____ Gallons; PT _____ Date _____

Pump Make: _____ Model _____ Serial No. _____

Nitrification Field: No Fields 1 Square Feet 1200 Linear Feet 400

No Lines 5 Trench Width 36" Max Trench Bottom Depth 32" Gravel Depth _____

☑ New System ☐ Repair System Type: I, (II), III, IV, V, VI

System Description: CONV - DIST BOX

Repair System Description: PANEL

Maintenance Agreement Required: ☐ Yes ☑ No

☑ House/Mod. Home No. Bedrooms 3

☐ Mobile Home No. Bathrooms 2

☐ Business No. Employees _____

☐ Other _____


☐ Slab ☑ Crawl Space ☐ Basement w/plumbing ☐ Basement wo/plumbing

Water Supply: ☑ Individual ☐ Community ☐ Public


Comments: 4/24/95 changed to 5 80'x3' conventional trenches.

Comments: Installed as drawn.

INITIAL SITE SKETCH

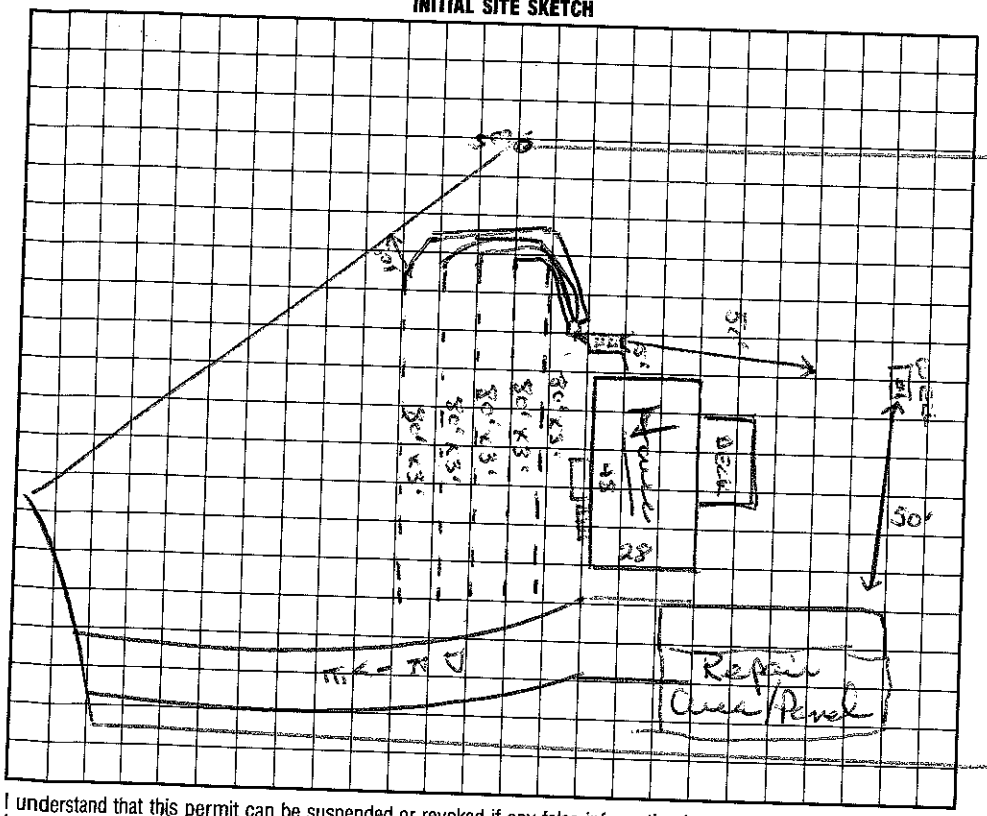

AS BUILT SKETCH

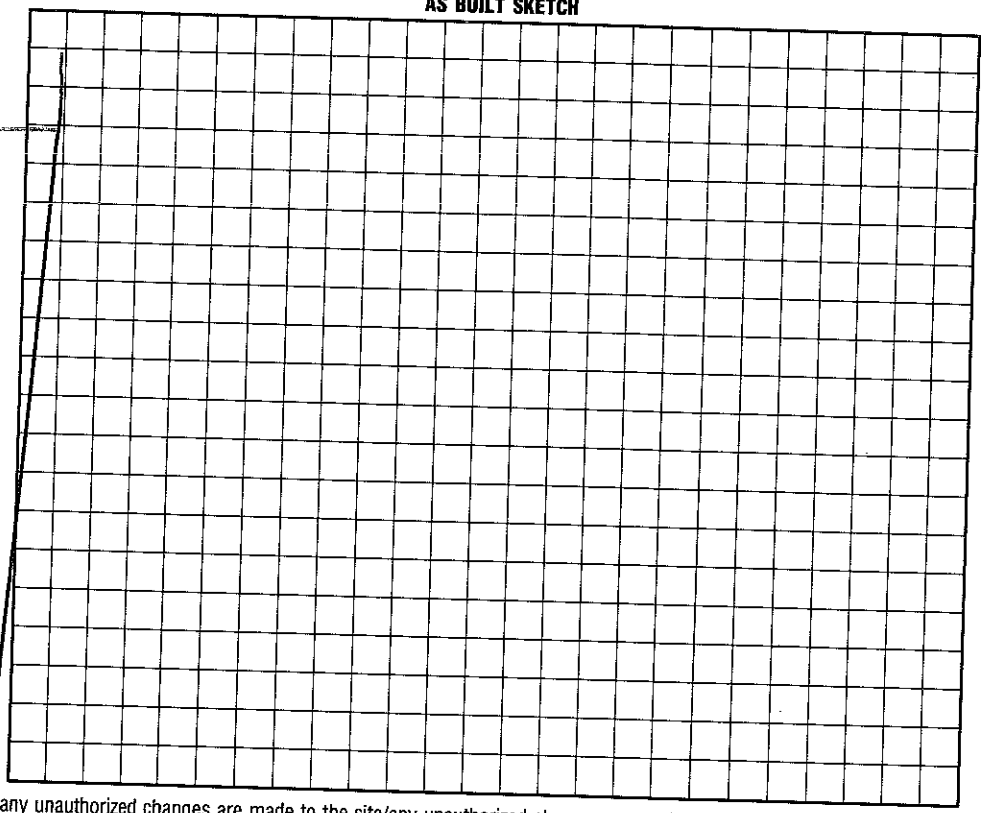

I understand that this permit can be suspended or revoked if any false information is supplied toward securing the permit/any unauthorized changes are made to the site/any unauthorized changes are made in the installation of the system. Improvement Permit is valid for 60 months from date of issuance.

Signed: Dana C. Beatty

Improvement Permit by: Wesley Sparks RS. date 4/24/95

Existing System Inspection by: _____ date _____

Installed by: B & W Contracting

Certificate of Completion by: Wesley Sparks RS. date 4/27/95

Operation Permit by: _____ date _____

HEALTH DEPT. COPY: WHITE | INSPECTION COPY (FINAL): GREEN | OWNER COPY (FINAL): YELLOW | INSPECTION COPY (INITIAL): PINK | OWNER COPY (INITIAL): GOLD