IREDELL COUNTY HEALTH DEPARTMENT

STATESVILLE 704-878-5305 MOORESVILLE 704-664-5281

IMPROVEMENT PERMIT / AUTHORIZATION TO CONSTRUCT / OPERATION PERMIT / EXISTING SYSTEM INSPECTION

PERMIT# 12120 for PIN# 4751323733.000 DATE March 7, 05

OWNER OR CONTRACTOR Linda Blyler PHONE: Business 704-832-4566 Home 704-528-6571

ADDRESS 485 Ostwalt Cemetery Rd, Troutman 28166

LOCATION From Troutman, South on US 21 TL Ostwalt Cemetery Approx 1. Smiles on left

SUBDIVISION _____ BLOCK / SECTION _____ LOT _____ LOT AREA 200 x 400 SITE CLASS PS DESIGN FLOW 360 gpd L.T.A.R. ~.3

Septic Tank: 1000 Gallons; STB 794 Date 3-25-05
Pump Tank: _____ Gallons; PT _____ Date _____
Pump Make: _____ Model _____ Serial No. _____
Nitrification Field: No Fields 1 Square Feet 1200 Linear Feet 400
No Lines ~4 Trench Width 36" Max Trench Bottom Depth 36"

☑ New System ☐ Repair System Type: I, II, III, IV, V, VI
System Description: GRAVITY CONVENTIONAL
Repair System Description: GravPumped 25% Reduction
Maintenance Agreement Required: ☐ Yes ☑ No
Gravel Depth 12"


☑ House/Mod. Home No. Bedrooms 3
☐ Mobile Home No. Bathrooms _____
☐ Business No. Employees _____
☐ Other _____
☐ Slab ☐ Crawl Space ☐ Basement w/plumbing ☑ Basement wo/plumbing (partial)

Water Supply: ☑ Individual existing ☐ Public ☐ Community


Comments:/Conditions: All WASTEWATER plumbing to be routed to New Septic TANK System replacement due to proposed Garage Addition. Unable to locate intact drainfield by probing (reygold)

Comments:/Conditions: ① RED 'POLYLOK' FILTER IN TANK

INITIAL SITE SKETCH

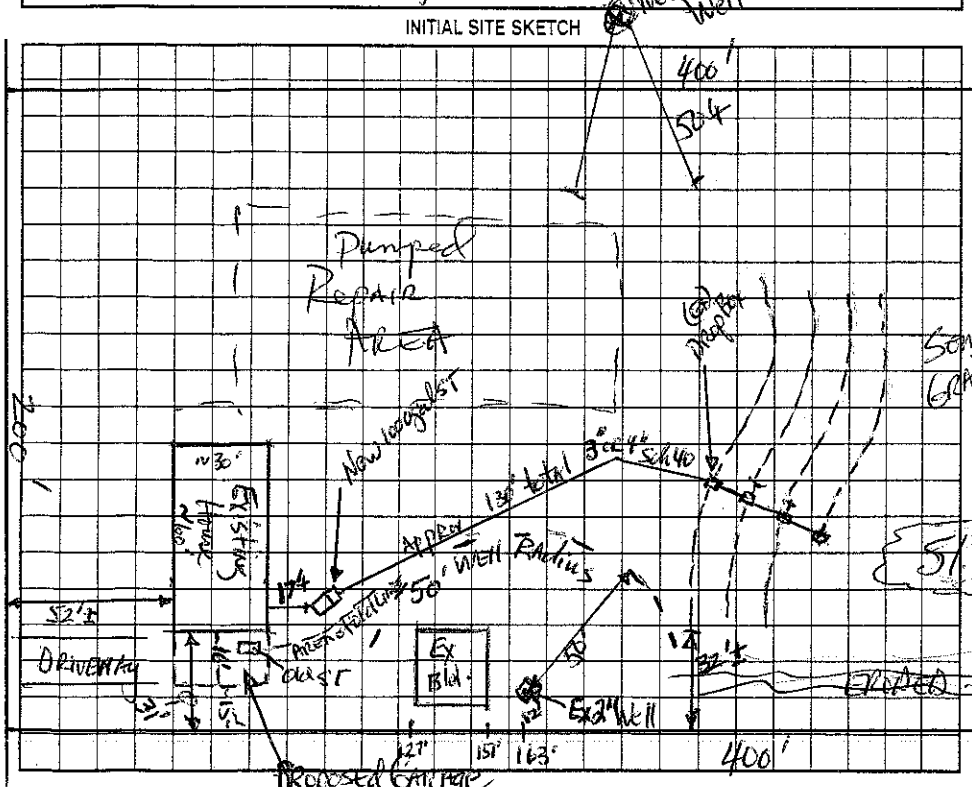

AS BUILT SKETCH

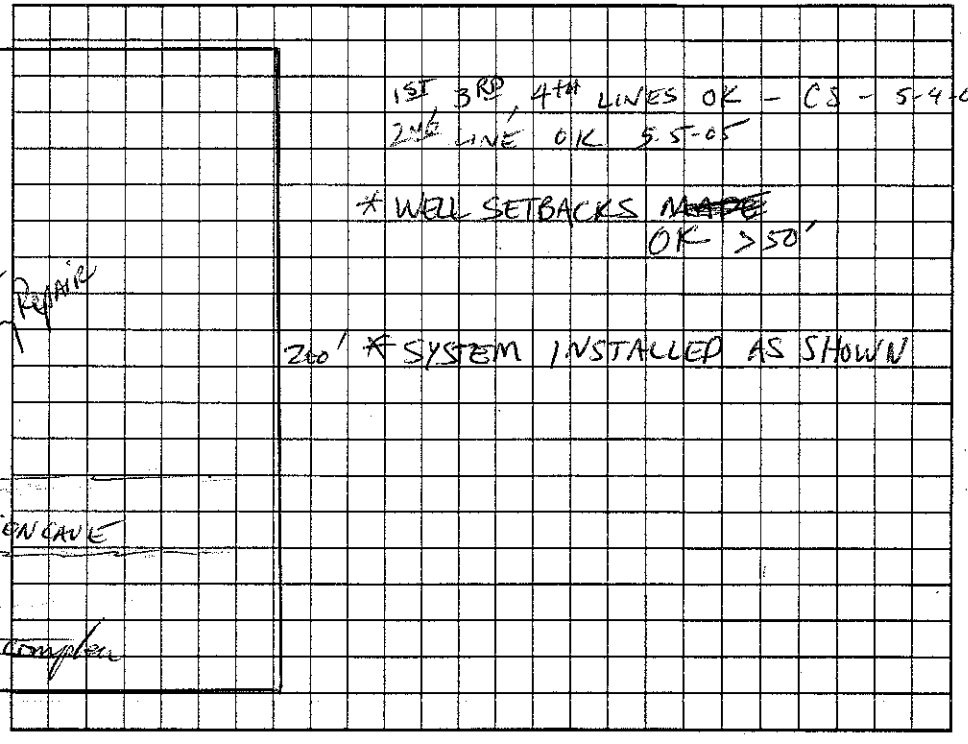

Permit can be suspended or revoked if any false information is supplied toward securing the permit/any unauthorized changes are made to the site/any unauthorized changes are made in the installation of the system. Improvement Permit with plat valid without expiration. Improvement Permit with site plan valid for sixty months. Authorization to Construct is valid for a period equal to that of Improvement Permit – not to exceed sixty months.

Signed: Linda S. Blyler date 3-9-05

Improvement Permit by: _____ date 3-7-05

Authorization to Construct by: _____ date 3-7-05

Installed by: TUCKER HAULING & GRADING

Operation Permit by: Christopher M. Shem REHS date 5-5-05

Existing System Inspection by: _____ date _____

HEALTH DEPT. COPY: WHITE OWNER COPY (FINAL): YELLOW OWNER COPY (INITIAL): PINK