Repair

IREDELL COUNTY HEALTH DEPARTMENT

STATESVILLE 704-878-5305 MOORESVILLE 704-664-5281

IMPROVEMENT PERMIT / AUTHORIZATION TO CONSTRUCT / OPERATION PERMIT / EXISTING SYSTEM INSPECTION

PERMIT# Repair PIN#

OWNER OR CONTRACTOR Jeremy Plyler PHONE: Business 902-1968 Mobile Home DATE 6-28-2001

ADDRESS 306 Pitch Rd Troutman 28166

LOCATION Hwy 21 S TL Oswalt Amity Rd TL Pitch Rd ~2 mile just past Chicken Hatchery

SUBDIVISION BLOCK / SECTION LOT LOT AREA SITE CLASS PS DESIGN FLOW 360 gpd L.T.A.R. .3-.35

Septic Tank: Existing Gallons: STB 1012 Date 12/9-00
Pump Tank: Gallons: PT Date
Pump Make: Model Serial No.
Nitrification Field: No Fields 1 Square Feet Linear Feet 180'
No Lines 2 Trench Width 36" Max Trench Bottom Depth Gravel Depth 12"

X New System ☐ Repair System Type: I II III IV V VI
System Description: Gravity-Conventional
Repair System Description: Gravity-Conventional
Maintenance Agreement Required: ☐ Yes X No


X House/Mod. Home ☐ Mobile Home ☐ Business ☐ Other
No. Bedrooms 2 No. Bathrooms 1 No. Employees
☐ Slab ☐ Crawl Space X Basement w/plumbing ☐ Basement wo/plumbing

Water Supply: X Individual ☐ Public ☐ Community

Comments/Conditions: Install 2 gravity drainlines LQ 100' with drop box 2nd @ 80' Use existing tank if in good shape.

Comments/Conditions: Complex topo. makes lot tight. Must stay 15' from top of slope if > 2'.

INITIAL SITE SKETCH

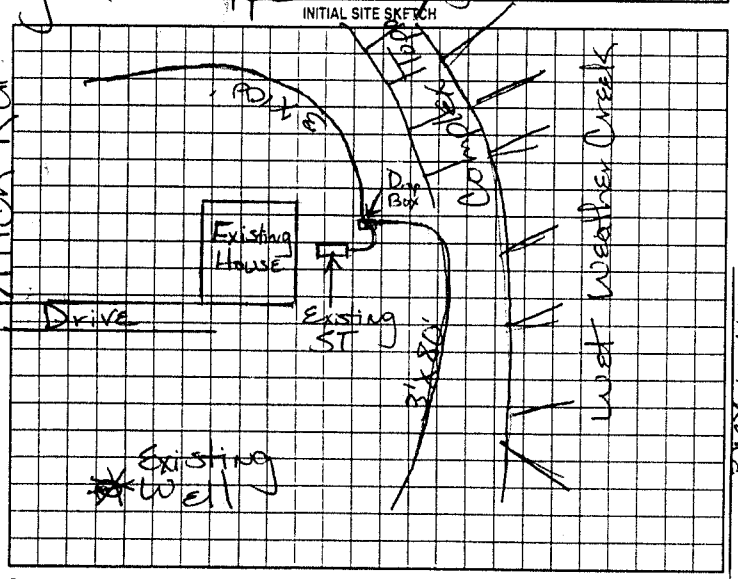


AS BUILT SKETCH

Existing Septic System to be repaired ~40-50 yrs old

Not to scale

(Replaced Tank)

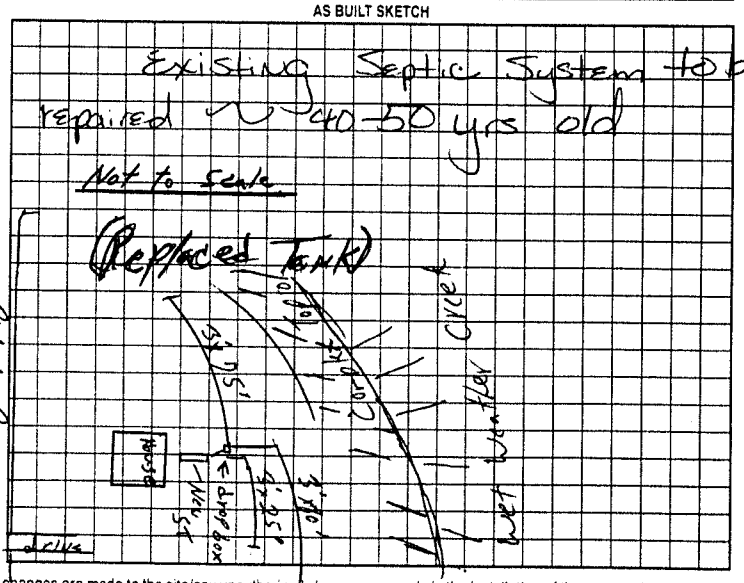

Permit can be suspended or revoked if any false information is supplied toward securing the permit/any unauthorized changes are made to the site/any unauthorized changes are made in the installation of the system. Improvement Permit with plat valid without expiration. Improvement Permit with site plan valid for sixty months. Authorization to Construct is valid for a period equal to that of Improvement Permit – not to exceed sixty months.

Signed X Well & Plat for Jeremy Plyler date Installed by: Richard Abernathy

Improvement Permit by: Mariah H. Tolson RS date 6/27/2001 Operation Permit by: William A Johnson date 7/19/01

Authorization to Construct by: Mariah H. Tolson RS. date 6/27/2001 Existing System Inspection by: date

HEALTH DEPT. COPY WHITE OWNER COPY (FINAL) YELLOW OWNER COPY (INITIAL) PINK