IREDELL COUNTY HEALTH DEPARTMENT

STATESVILLE 704-878-5305 MOORESVILLE 704-664-5281

IMPROVEMENT PERMIT / CERTIFICATE OF COMPLETION / OPERATION PERMIT / EXISTING SYSTEM INSPECTION

PROPERTY DESCRIPTION NO. _____ DATE 7-18-96 TAX MAP NO. _____ Watershed: ☐ Yes ☐ No

OWNER OR CONTRACTOR Mrs. Harry Plyler PHONE: Business _____ Home 872-1104

ADDRESS 260 Pilch Rd

LOCATION I-77 TL Amity Hill TR Pilch Inn Rd

SUBDIVISION _____ BLOCK / SECTION _____ LOT _____ LOT AREA acreage SITE CLASS. _____ DESIGN FLOW 240 L.T.A.R. .3

Septic Tank: Ex. Gallons; STB _____ Date _____

Pump Tank: _____ Gallons; PT _____ Date _____

Pump Make: _____ Model _____ Serial No. _____

Nitrification Field: No Fields 1 Square Feet 450 Linear Feet 150

No Lines 1 Trench Width 36" Max Trench Bottom Depth 36" Gravel Depth 12" TL

☐ New System ☑ Repair System Type: I (II) III. IV. V. VI

System Description: _____

Repair System Description: Conv. Gravity

Maintenance Agreement Required: ☐ Yes ☑ No

☐ House/Mod. Home No. Bedrooms 2

☐ Mobile Home No. Bathrooms 1

☐ Business No. Employees _____

☐ Other _____


☐ Slab ☑ Crawl Space ☐ Basement w/plumbing ☐ Basement wo/plumbing

Water Supply: ☑ Individual ☐ Community ☐ Public

Comments:

3, X 150'

INITIAL SITE SKETCH

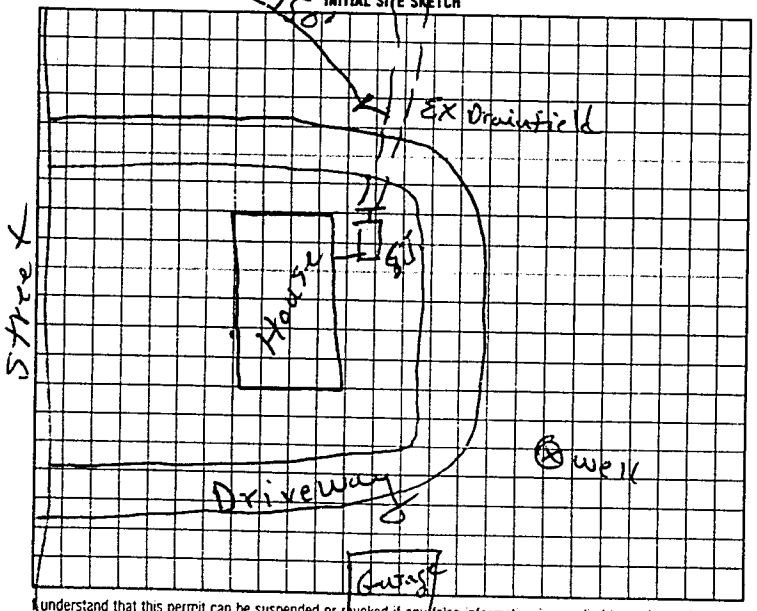

Comments:

AS BUILT SKETCH

Same as initial sketch

I understand that this permit can be suspended or revoked if any false information is supplied toward securing the permit/any unauthorized changes are made to the site/any unauthorized changes are made in the installation of the system.

Signed: Willard W. Plyler

Improvement Permit by P.C. Moore date 7-18-96

Authorization to Construct by P.C. Moore date 7-18-96

Installed by Larry Beam

Certificate of Completion by _____ date _____

Operation Permit by P.C. Moore date 8-15-96

Authorization to Construct expires 60 mos from issue

IMPROVEMENT PERMIT COPY WHITE — AUTHORIZATION TO CONSTRUCT COPY (FINAL) GREEN — OWNER COPY (FINAL) YELLOW — INSPECTION COPY (INITIAL) PINK — OWNER COPY (INITIAL) GOLD

268100