IREDELL COUNTY HEALTH DEPARTMENT

STATESVILLE 704-878-5305 (C1) MOORESVILLE 704-664-5281

IMPROVEMENT PERMIT / AUTHORIZATION TO CONSTRUCT / OPERATION PERMIT / EXISTING SYSTEM INSPECTION

PERMIT# 111390 PIN# 4751-37-2321 DATE 07/15/03

OWNER OR CONTRACTOR ASHLEY PLYLER PHONE: Business 704-528-6638 Home PAGER 704-229-0927

ADDRESS 313 PILCH RD. TROUTMAN, NC 28166

LOCATION I77 SOUTH, (L) AMITY HILL RD., (R) PILCH, ~0.75 MILES ON RIGHT, ~630' FROM ROAD TO HOME SITE.

SUBDIVISION — BLOCK / SECTION — LOT — LOT AREA 39.8 ACRES SITE CLASS. PS DESIGN FLOW 240 GPD L.T.A.R. 0.30 GPD/FT²

Septic Tank: 1,000 Gallons; STB 312 Date 7-20-03
Pump Tank: ____ Gallons; PT ____ Date ____
Pump Make: ____ Model ____ Serial No. ____
Nitrification Field: No Fields 1 Square Feet 900 Linear Feet 300
No Lines 7 Trench Width 36" Max Trench Bottom Depth 36" Gravel Depth 12"+

☒ New System ☐ Repair System Type: I, (II), III, IV, V, VI
System Description: CONVENTIONAL, GRAVITY
Repair System Description: CONVENTIONAL, GRAV/PUMP
Maintenance Agreement Required: ☐ Yes ☒ No


☐ House/Mod. Home No. Bedrooms 2
☒ Mobile Home No. Bathrooms 2
☐ Business No. Employees ____
☐ Other ____
☐ Slab ☒ Crawl Space ☐ Basement w/plumbing ☐ Basement wo/plumbing

Water Supply: ☒ Individual ☐ Public ☐ Community
WELL

Comments/Conditions:

Comments/Conditions: SEPTIC TANK WITH MARKER INSTALLED
USING "ZABEL" FILTER

INITIAL SITE SKETCH

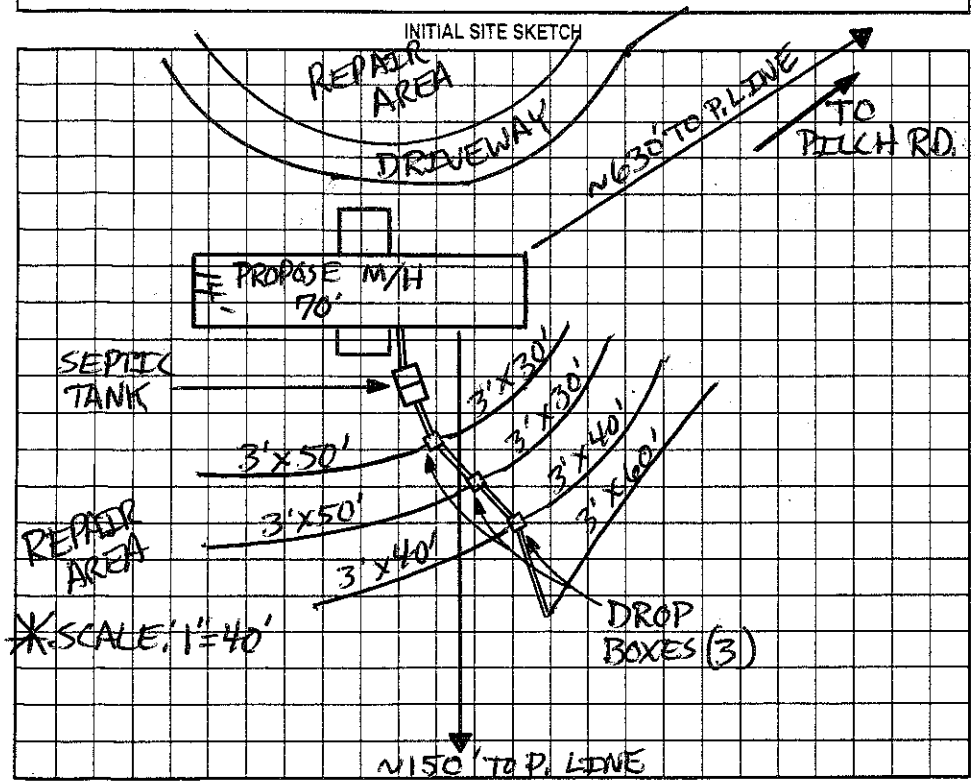

AS BUILT SKETCH

SYSTEM INSTALLED ACCORDING TO INITIAL SITE SKETCH

Permit can be suspended or revoked if any false information is supplied toward securing the permit/any unauthorized changes are made to the site/any unauthorized changes are made in the installation of the system. Improvement Permit with plat valid without expiration. Improvement Permit with site plan valid for sixty months. Authorization to Construct is valid for a period equal to that of Improvement Permit – not to exceed sixty months.

Signed: Ashley Plyler date 7/16/03
Improvement Permit by: Patrick Mitchell date 07/15/03
Authorization to Construct by: Patrick Mitchell date 07/15/03

Installed by: MARTY TUCKER
Operation Permit by: STEVE HEDRICK date 8-26-03
Existing System Inspection by: ____ date ____

HEALTH DEPT. COPY: WHITE OWNER COPY (FINAL): YELLOW OWNER COPY (INITIAL): PINK