IREDELL COUNTY HEALTH DEPARTMENT

STATESVILLE 704-878-5305 MOORESVILLE 704-664-5281

IMPROVEMENT PERMIT / AUTHORIZATION TO CONSTRUCT / OPERATION PERMIT / EXISTING SYSTEM INSPECTION

PERMIT# 74746 PIN# 4751 38 1759 DATE 7-23-98

OWNER OR CONTRACTOR Timothy Lancaster PHONE: Business S Home 873 6551

ADDRESS 141 Nana's Lane

LOCATION I-77 T6 Amity Hill TR Nana's Ln 1/4 mi Rt

SUBDIVISION BLOCK / SECTION LOT LOT AREA 2.59 acres SITE CLASS. PS DESIGN FLOW 360 L.T.A.R. .24

Septic Tank: 1000 Gallons; STB 760 Date 2-22-00
Pump Tank: Gallons; PT Date
Pump Make: Model Serial No.
Nitrification Field: No Fields 1 Square Feet 1500 Linear Feet 500
No Lines 4 Trench Width 36" Max Trench Bottom Depth 36" Gravel Depth 12"

☑ New System ☐ Repair System Type: I (II) III, IV, V, VI
System Description: Conv. Gravity
Repair System Description:
Maintenance Agreement Required: ☐ Yes ☑ No
☐ Slab ☑ Crawl Space ☐ Basement w/plumbing ☐ Basement wo/plumbing


☑ House/Mod. Home No. Bedrooms 3
☐ Mobile Home No. Bathrooms 2
☐ Business No. Employees
☐ Other

Water Supply: ☑ Individual ☐ Public ☐ Community


Comments:/Conditions:

Comments:/Conditions:
SEPTIC TANK W/ RISERS INSTALLED USING "ZABEL" FILTER

INITIAL SITE SKETCH

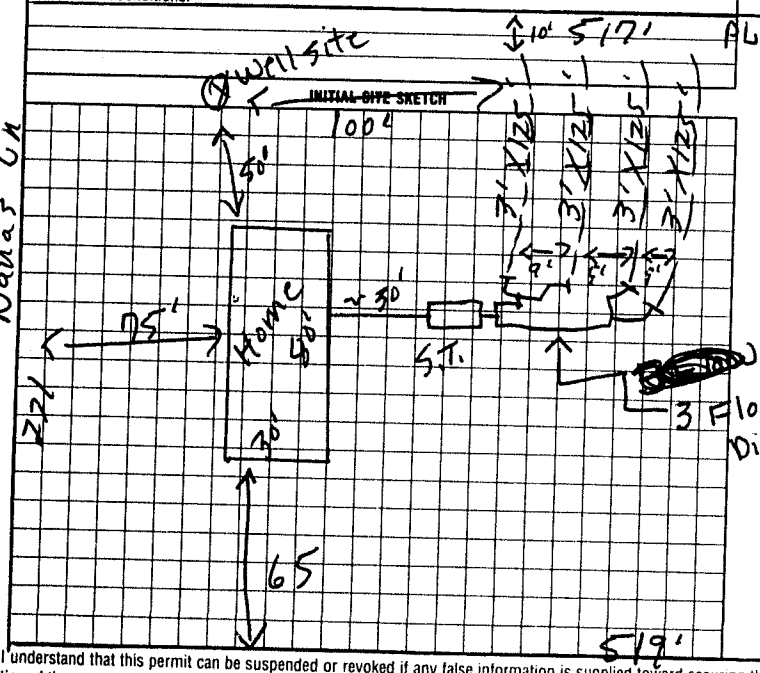

AS BUILT SKETCH

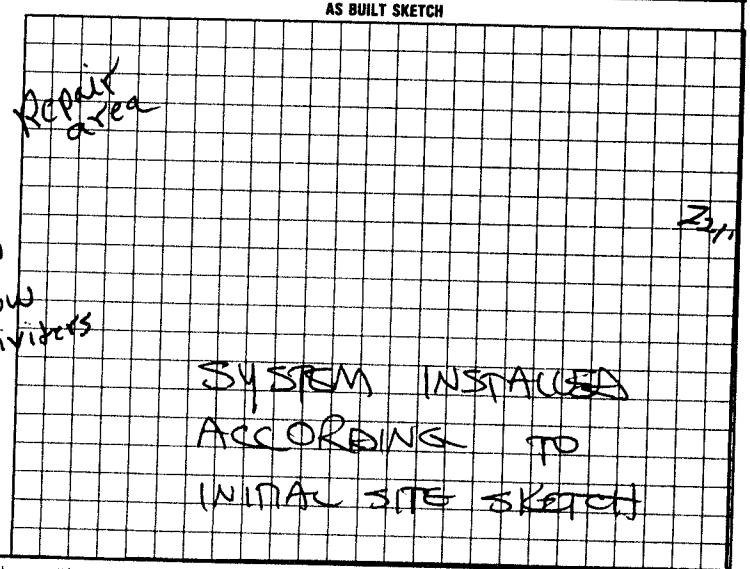

I understand that this permit can be suspended or revoked if any false information is supplied toward securing the permit/any unauthorized changes are made to the site/any unauthorized changes are made in the installation of the system. Improvement Permit with plat valid without expiration. Improvement Permit with site plan valid for sixty months. Authorization to Construct is valid for a period equal to that of Improvement Permit – not to exceed sixty months.

Signed: X Deborah Lancaster

Improvement Permit by: P.C. Moore date 7-23-98

Authorization to Construct by: P.C. Moore date 7-23-98

Installed by: STEVE BRYANT

Operation Permit by: STEVE HERRICK date 6-30-2000

Existing System Inspection by: date

HEALTH DEPT. COPY: WHITE INSPECTION COPY (FINAL): GREEN OWNER COPY (FINAL): YELLOW INSPECTION COPY (INITIAL): PINK OWNER COPY (INITIAL): GOLD