IREDELL COUNTY HEALTH DEPARTMENT

STATESVILLE 704-878-5305 MOORESVILLE 704-664-5281

IMPROVEMENT PERMIT / AUTHORIZATION TO CONSTRUCT / OPERATION PERMIT / EXISTING SYSTEM INSPECTION

PERMIT# 79787 PIN# 4751 28 1170 DATE 3-26-99

OWNER OR CONTRACTOR Marlene Tucker PHONE: Business Home 872-7001

ADDRESS 404 Dover Rd Statesville N.C.

LOCATION Amity Hill Rd Turn on Wanna's Lane atent

SUBDIVISION BLOCK / SECTION LOT 3 LOT AREA 3.0 acres SITE CLASS P3 DESIGN FLOW 360 L.T.A.R. 1.3

Septic Tank: 1000 Gallons; STB 794 Date 2-26-99

Pump Tank: Gallons; PT Date

Pump Make: Model 900 Serial No. 300

Nitrification Field: No Fields 1 Square Feet ~~1800~~ Linear Feet ~~400~~

No Lines 3 Trench Width 36" Max Trench Bottom Depth 24" Gravel Depth N/A

☐ New System ☐ Repair System Type: I, II, III, IV, V, VI

System Description: Gravity 25% Red.

Repair System Description:

Maintenance Agreement Required: ☐ Yes ☐ No

☐ Slab ☐ Crawl Space ☐ Basement w/plumbing ☐ Basement wo/plumbing

☐ House/Mod. Home No. Bedrooms 3

☑ Mobile Home No. Bathrooms 2

☐ Business No. Employees


☐ Other

Water Supply: ☑ Individual ☐ Public ☐ Community


Comments/Conditions:

Comments/Conditions: Well not on site at time of this inspection

INITIAL SITE SKETCH

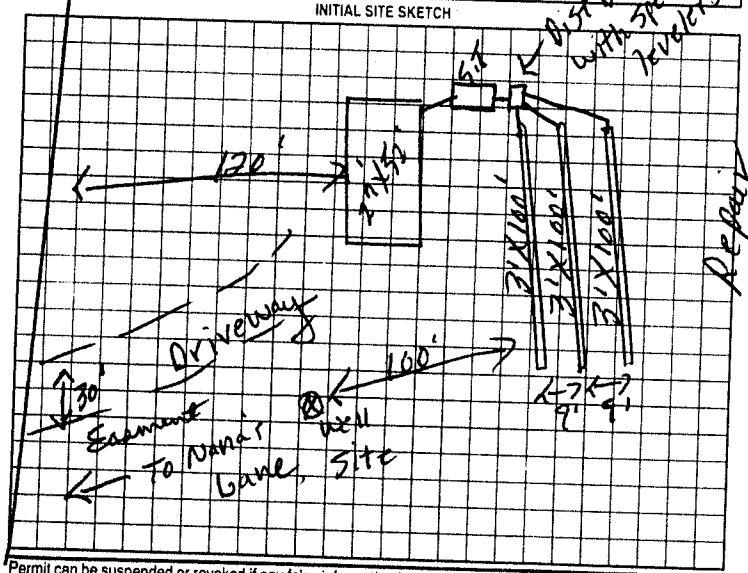

AS BUILT SKETCH

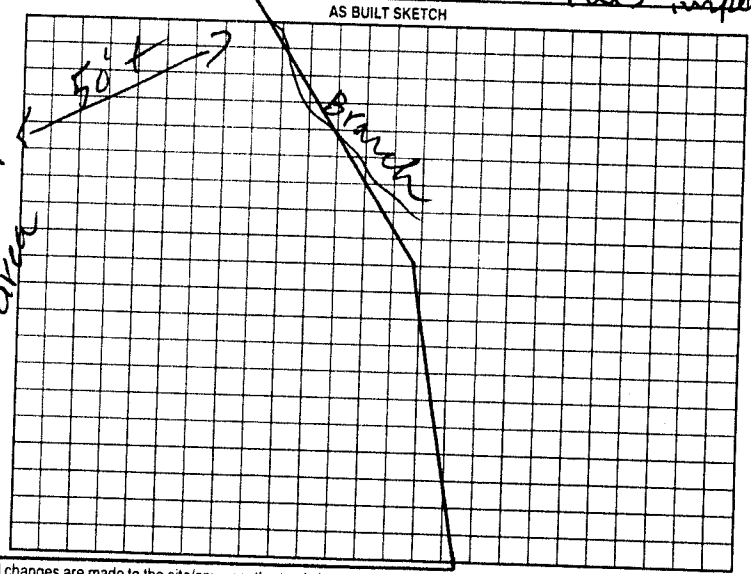

Permit can be suspended or revoked if any false information is supplied toward securing the permit/any unauthorized changes are made to the site/any unauthorized changes are made in the installation of the system. Improvement Permit with plat valid without expiration. Improvement Permit with site plan valid for sixty months. Authorization to Construct is valid for a period equal to that of Improvement Permit – not to exceed sixty months.

Signed: Marlene Tucker date 3-30-99 Installed by: Craig Moore

Improvement Permit by: F.C. Moore date 3-26-99 Operation Permit by: F.C. Moore date 5-24-99

Authorization to Construct by: F.C. Moore date 3-26-99 Existing System Inspection by: date

HEALTH DEPT. COPY: WHITE OWNER COPY (FINAL) YELLOW OWNER COPY (INITIAL) PINK