IREDELL COUNTY HEALTH DEPARTMENT

STATESVILLE 704-878-5305 MOORESVILLE 704-664-5281

IMPROVEMENT PERMIT / CERTIFICATE OF COMPLETION / OPERATION PERMIT / EXISTING SYSTEM INSPECTION

PROPERTY DESCRIPTION NO. 3600 1 065293 DATE 1-31-97 TAX MAP NO. 4751-38-2560 Watershed: ☐ Yes ☒ No

OWNER OR CONTRACTOR Floyd McCarter PHONE: Business _____ Home 803-222-9873

ADDRESS 424 Briggs Rd. Clover S.C. 29710

LOCATION I-77 S TL Amity Hill Rd TR Nanna Lane 1/4mi left.

SUBDIVISION _____ BLOCK / SECTION _____ LOT _____ LOT AREA 1 acre SITE CLASS. PS DESIGN FLOW 480 L.T.A.R. .13

Septic Tank: 1000 Gallons; STB 774 Date 4-1997

Pump Tank: _____ Gallons; PT _____ Date _____

Pump Make: _____ Model _____ Serial No. _____

Nitrification Field: No Fields ___ Square Feet 1600 Linear Feet 533

No Lines 4 Trench Width 36" Max Trench Bottom Depth 36" Gravel Depth 12"

☒ New System ☐ Repair System Type: I, II, III, IV, V, VI

System Description: Conv. Gravity

Repair System Description: Gravity Chambers

Maintenance Agreement Required: ☐ Yes ☒ No

☒ House/Mod. Home No. Bedrooms 4
☐ Mobile Home No. Bathrooms 2
☐ Business No. Employees ___
☐ Other _____


☐ Slab ☒ Crawl Space ☐ Basement w/plumbing ☐ Basement wo/plumbing

Water Supply: ☒ Individual ☐ Community ☐ Public


Comments:

Comments:

INITIAL SITE SKETCH

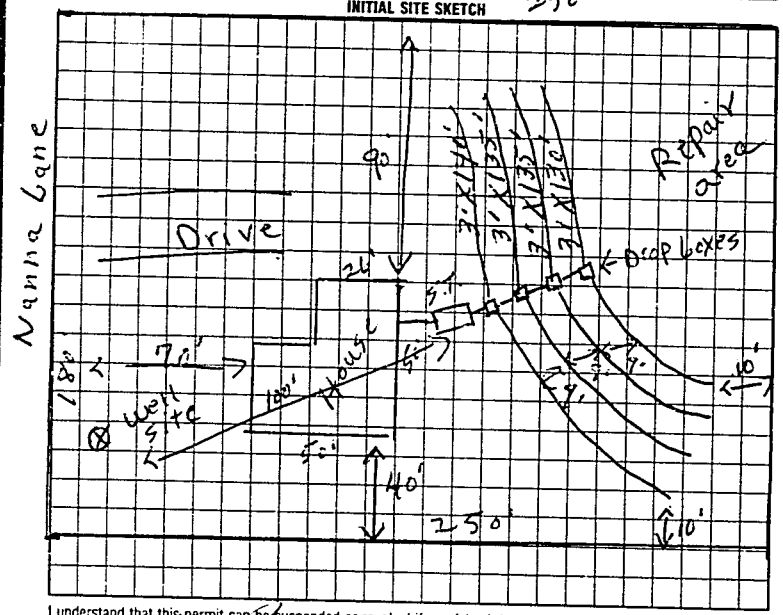

AS BUILT SKETCH

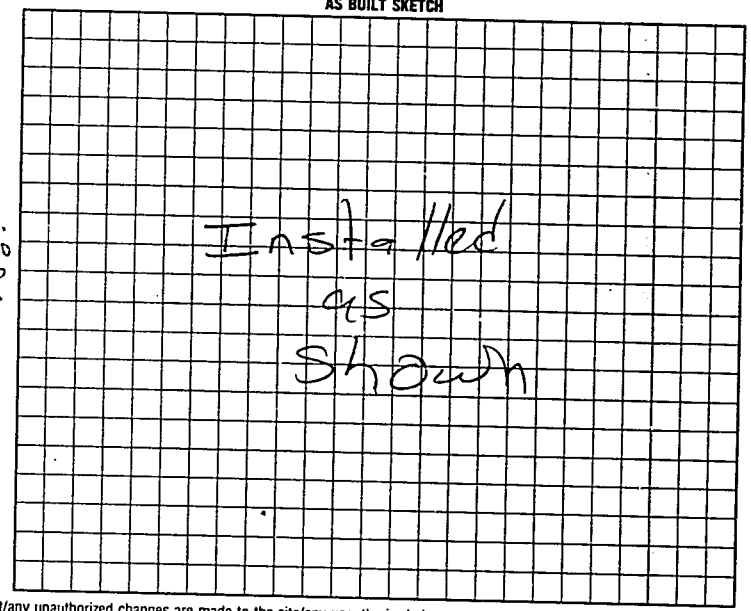

I understand that this permit can be suspended or revoked if any false information is supplied toward securing the permit/any unauthorized changes are made to the site/any unauthorized changes are made in the installation of the system. Improvement Permit is valid for 60 months from date of issuance.

Signed: Matt Brown for Floyd McCarter 1-31-97

Improvement Permit by: L.C. Moore date 1-31-97

Authority to Construct Existing system inspection by: L.C. Moore date 1-31-97

Installed by: James Hudgens

Certificate of Completion by: _____ date _____

Operation Permit by: Mark Cox RS date 7-21-97

HEALTH DEPT. COPY (WHITE) INSPECTION COPY (FINAL): GREEN OWNER COPY (FINAL): YELLOW INSPECTION COPY (INITIAL): PINK OWNER COPY (INITIAL): GOLD

+ authorization to Const. Expires 60 mos from date issued