IREDELL COUNTY HEALTH DEPARTMENT

STATESVILLE 704-878-5305 MOORESVILLE 704-664-5281

IMPROVEMENT PERMIT / AUTHORIZATION TO CONSTRUCT / OPERATION PERMIT / EXISTING SYSTEM INSPECTION

PERMIT# 02766 PIN# 4751-93 6377 Builder—Robert Crouch DATE 10-23-2001

OWNER OR CONTRACTOR Donald Beaver PHONE Business 828 312-0803 Home 828 324-8810

ADDRESS 5995 Gold Creek Estates Dr. Hickory, NC 28601

LOCATION Hwy 21 S TL Oswalt Amity Rd ~1 3miles on left

SUBDIVISION BLOCK / SECTION LOT LOT AREA 95.6 Acre SITE CLASS PS DESIGN FLOW 360gpd L T A R .3

Septic Tank: 1000 Gallons: STB 1100 Date 11-5-01
Pump Tank: Gallons: PT Date
Pump Make: Model Serial No
Nitrification Field: No Fields 1 Square Feet 1200' Linear Feet 400'
No Lines 5 @ 80' Trench Width 36" Max Trench Bottom Depth 36" Gravel Depth 12"

X New System Repair System Type: I II III IV V VI
System Description: Gravity Conventional
Repair System Description: Same
Maintenance Agreement Required: Yes X No
Slab Crawl Space Basement w/plumbing Basement wo/plumbing


X House/Mod. Home No. Bedrooms 3
Mobile Home No. Bathrooms 2.5
Business No. Employees
Other

Water Supply: X Individual Public Community

Comments/Conditions: Keep Septic System at least 50' from existing well & 100' from New well

Comments/Conditions: Won't use existing well for water in house; will install a new one.

INITIAL SITE SKETCH

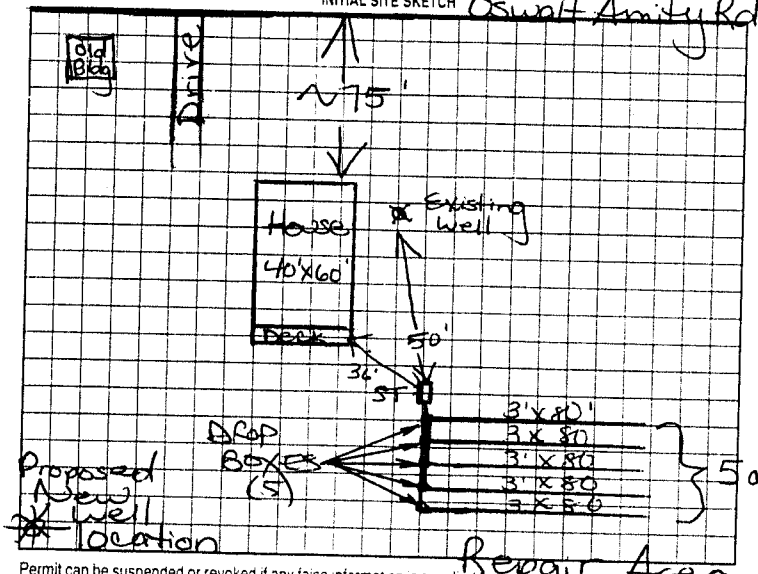

AS BUILT SKETCH

SEPTIC TANK WITH MARKER INSTALLED USING 'EABEL' FILTER

SYSTEM INSTALLED ACCORDING TO INITIAL SITE SKETCH

Permit can be suspended or revoked if any false information is supplied toward securing the permit any unauthorized changes are made to the site any unauthorized changes are made in the installation of the system. Improvement Permit with plat valid without expiration. Improvement Permit with site plan valid for sixty months. Authorization to Construct is valid for a period equal to that of Improvement Permit – not to exceed sixty months.

Signed: [signature] date Installed by: LEATHERMAN'S SEPTIC TANK

Improvement Permit by: Marian H. Dobson RS date 10/23/2001 Operation Permit by: STEVE HEDRICK date 1-11-02

Authorization to Construct by: Marian H. Dobson RS date 10/23/2001 Existing System Inspection by: date

HEALTH DEPT COPY: WHITE OWNER COPY (FINAL): YELLOW OWNER COPY (INITIAL): PINK