# IREDELL COUNTY HEALTH DEPARTMENT

STATESVILLE 704-878-5305 MOORESVILLE 704-664-5281

## IMPROVEMENT PERMIT / AUTHORIZATION TO CONSTRUCT / OPERATION PERMIT / EXISTING SYSTEM INSPECTION

PERMIT# Repair PIN# 4751477322 DATE 12-20-05

OWNER OR CONTRACTOR Jimmy Gaither PHONE: Business Home 873-3723

ADDRESS 209 Pilch RD Statesville NC

LOCATION Exit 45 I-77 (N) Turn Right Pilch Road 2 mile on Left

SUBDIVISION BLOCK / SECTION LOT LOT AREA Pace SITE CLASS R5 DESIGN FLOW 240 L.T.A.R. .13

Septic Tank: 1000 Gallons; STB Date

Pump Tank: Gallons; PT Date

Pump Make: Model Serial No.

Nitrification Field: No Fields 2 Square Feet 800 Linear Feet 200

No Lines 2 Trench Width 36" Max Trench Bottom Depth 36" Gravel Depth

☐ New System ☐ Repair System Type: I, II, III, IV, V, VI

System Description: ~~2510 — 2 100' lines~~

Repair System Description: 25% - 2100' Lines

Maintenance Agreement Required: ☐ Yes ☐ No

☐ House/Mod. Home No. Bedrooms 2

☐ Mobile Home No. Bathrooms

☐ Business No. Employees

☐ Other


☐ Slab ☐ Crawl Space ☐ Basement w/plumbing ☐ Basement wo/plumbing

Water Supply: ☐ Individual ☐ Public ☐ Community


Comments:/Conditions: Install on Contour
Maintain all setbacks

Comments:/Conditions:
2-100' 25% Reduction lines - Feed first - initial system feed last

INITIAL SITE SKETCH

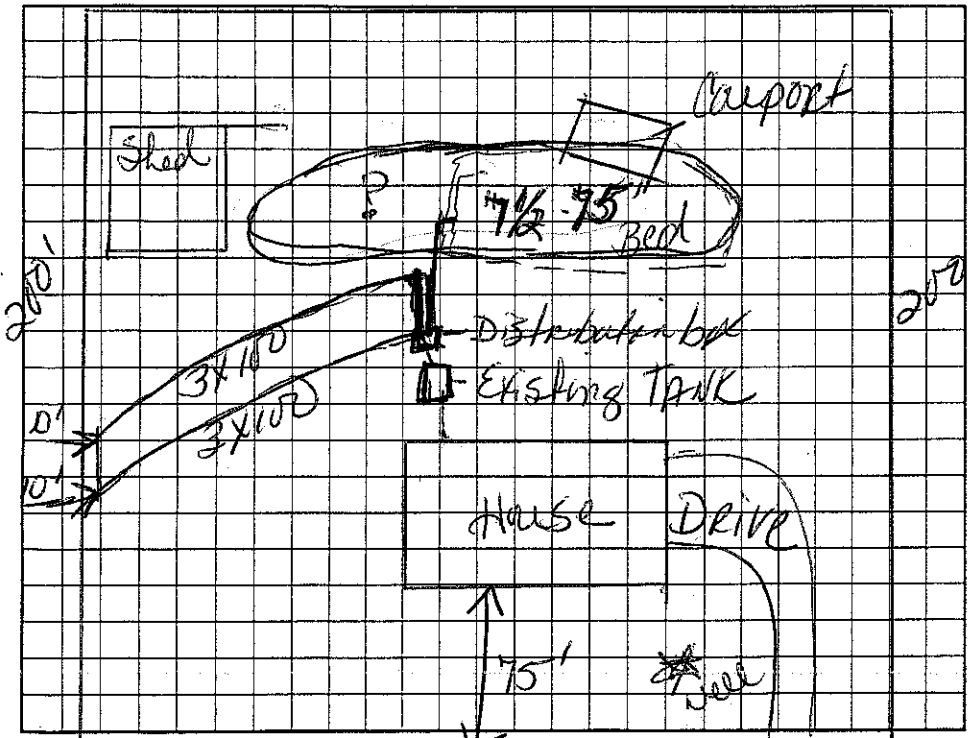


AS BUILT SKETCH

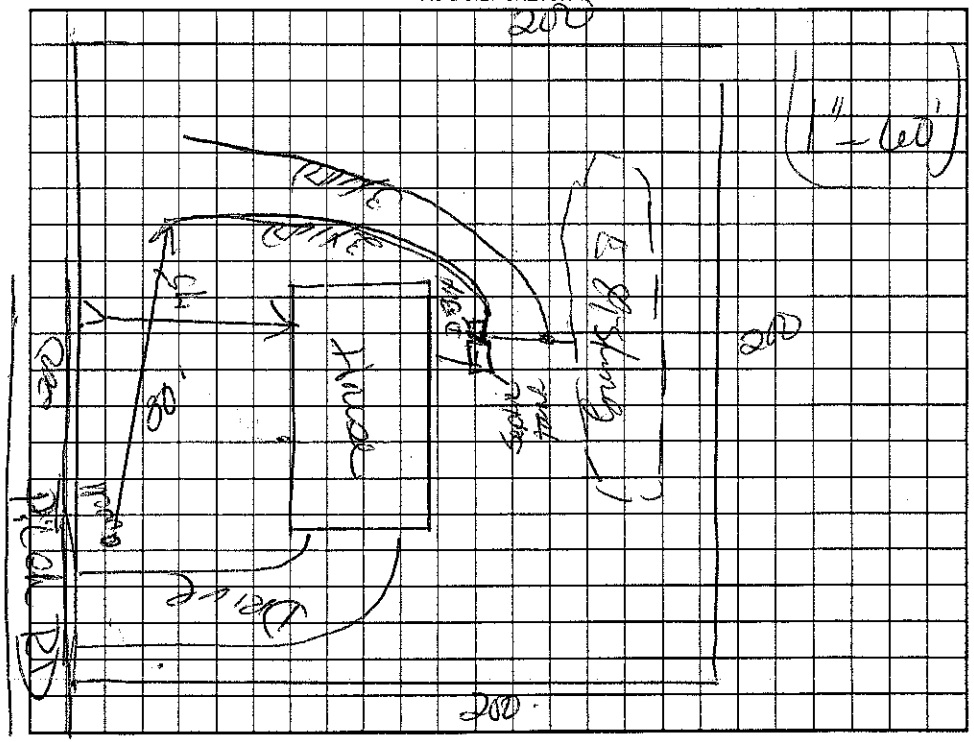


Permit can be suspended or revoked if any false information is provided by the applicant, unauthorized changes are made to the site/any unauthorized changes are made in the installation of the system. Improvement Permit with plat valid without expiration. Improvement Permit without plat valid for sixty months. Authorization to Construct is valid for a period equal to that of Improvement Permit – not to exceed sixty months.

Signed: date

Improvement Permit by: Kelly Cook date 12-20-05

Authorization to Construct by: Kelly Cook date 12-20-05

Installed by: H-I Jack Hoe

Operation Permit by: Kelly Cook date 12-27-05

Existing System Inspection by: date

HEALTH DEPT. COPY: WHITE OWNER COPY (FINAL): YELLOW OWNER COPY (INITIAL): PINK