IREDELL COUNTY HEALTH DEPARTMENT

Statesville Phone TR 3-7271 Mooresville Phone MO 3-1271

PERMIT TO INSTALL SEPTIC TANK

Permit NO. Jack Mills. Permit Date Sept 14 19 65

Owner Edmisten & Mills Address R7

Installed By C Hoke Address R7


Location of Property out Amity Hill Rd. Cross I-77 1st pave to Right on left ½ mile new start

Tank		Capacity		Length of Lines		Fixtures	
Block	( )	1000	( )	225'	( )	No. of Baths	(2)
Precast	(+)	1250	( )	250'	( )	Dishwasher	( )
		1500	( )	Other		Garbage Grdr.	( )
		Other				Other	

NOTIFY HEALTH DEPARTMENT AT LEAST EIGHT HOURS BEFORE TANK IS TO BE INSPECTED.

Final Inspection 19 Approved ( ) Disapproved ( )

Remarks well 55'

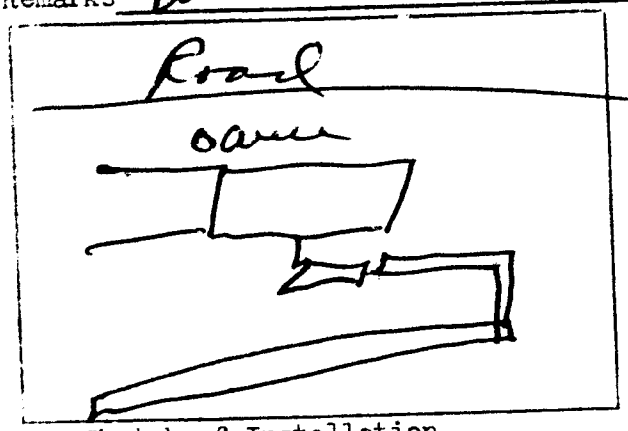

Sketch of Installation

Sanitarian