IREDELL COUNTY HEALTH DEPARTMENT

Statesville Phone TR 3-7271 Mooresville Phone NO 3-1271

PERMIT TO INSTALL SEPTIC TANK

Permit No. J A. mills Permit Date Aug 23 1966

Owner Edmiston & Mills Dev. Address R7

Installed By C Hoke Address R7


Location of Property out Amity Hill Rd to Road #2366 Paved to R- on left ½ mile

| Tank | | Capacity | | Length of Lines | | Fixtures | |
|---|---|---|---|---|---|---|---|
| Block | ( ) | 1000 | ( ) | 225' | ( ) | No. of Baths | (2) |
| Precast | (✓) | 1250 | ( ) | 250' | ( ) | Dishwasher | ( ) |
| | | 1500 | ( ) | Other | | Garbage Grdr. | ( ) |
| | | Other | | | | Other | |

NOTIFY HEALTH DEPARTMENT AT LEAST EIGHT HOURS BEFORE TANK IS TO BE INSPECTED.

Final Inspection 19 Approved ( ) Disapproved ( )

Remarks Heavy wooded - very deep -

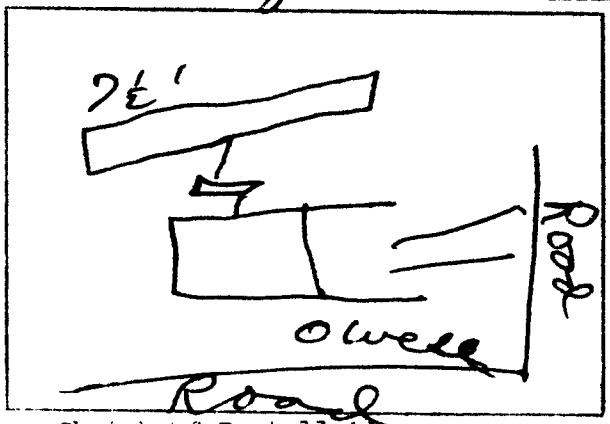


Sketch of Installation

Sanitarian