IREDELL COUNTY HEALTH DEPARTMENT

STATESVILLE 704-878-5305 MOORESVILLE 704-664-5281

IMPROVEMENT PERMIT / AUTHORIZATION TO CONSTRUCT / OPERATION PERMIT / EXISTING SYSTEM INSPECTION

PERMIT# 76804 PIN# 4751 48 1912 DATE 10-14-98

OWNER OR CONTRACTOR Sunwood Bldg. Perry C. Jenkins PHONE: Business 872 0922 Home

ADDRESS Po Box 5877 Statesville, N.C.

LOCATION I-77 TO Amity Hill TR Pilch Rd TR Freda Ln 500' left

SUBDIVISION Crater Valley BLOCK / SECTION LOT 5 LOT AREA 1.62 acres SITE CLASS PS DESIGN FLOW 360 L.T.A.R. 128

Septic Tank: 1000 Gallons; STB 1012 Date 11-21-98
Pump Tank: Gallons; PT Date
Pump Make: Model Serial No.
Nitrification Field: No Fields 1 Square Feet 990 Linear Feet 330
No Lines 6 Trench Width 36" Max Trench Bottom Depth 36" Gravel Depth N/A

☑ New System ☐ Repair System Type: I, II, III, IV, V, VI
System Description: Gravity 25% Red.
Repair System Description:
Maintenance Agreement Required: ☐ Yes ☑ No


☐ House/Mod. Home No. Bedrooms 3
☐ Mobile Home No. Bathrooms 2
☐ Business No. Employees
☐ Other
☐ Slab ☐ Crawl Space ☐ Basement w/plumbing ☐ Basement wo/plumbing

Water Supply: ☑ Individual ☐ Public ☐ Community

Comments:/Conditions:

Comments:/Conditions:

INITIAL SITE SKETCH

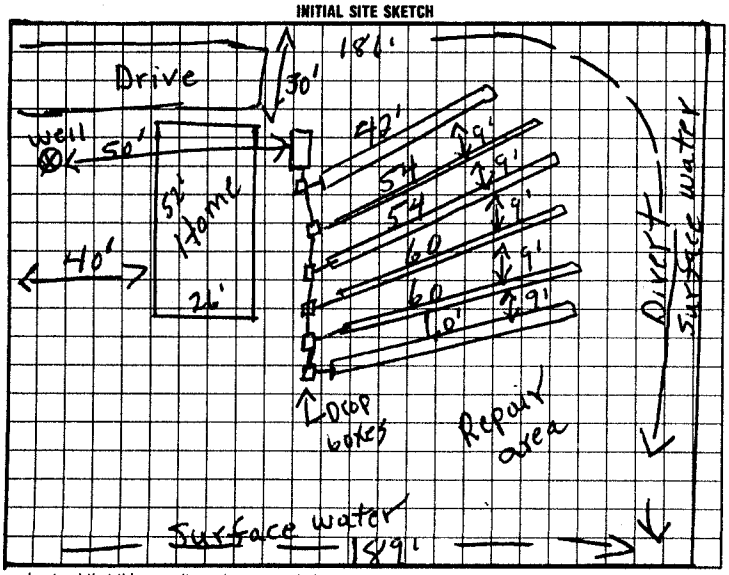

AS BUILT SKETCH

I understand that this permit can be suspended or revoked if any false information is supplied toward securing the permit/any unauthorized changes are made to the site/any unauthorized changes are made in the installation of the system. Improvement Permit with plat valid without expiration. Improvement Permit with site plan valid for sixty months. Authorization to Construct is valid for a period equal to that of Improvement Permit – not to exceed sixty months.

Signed: Perry W Jenkins date Installed by: Tammy Frye

Improvement Permit by: P. C. Moore date 10-14-98 Operation Permit by: [illegible] date 2-26-99

Authorization to Construct by: P. C. Moore date 10-14-98 Existing System Inspection by: date

HEALTH DEPT. COPY (FINAL) WHITE INSPECTION COPY (FINAL) GREEN OWNER COPY (FINAL) YELLOW INSPECTION COPY (INITIAL) PINK OWNER COPY (INITIAL) GOLD