IREDELL COUNTY HEALTH DEPARTMENT

STATESVILLE 704-878-5305 MOORESVILLE 704-664-5281

IMPROVEMENT PERMIT / AUTHORIZATION TO CONSTRUCT / OPERATION PERMIT / EXISTING SYSTEM INSPECTION

PERMIT# 069264 PIN# 4751484629 DATE 6-17-98

OWNER OR CONTRACTOR Sygwood Builders PHONE: Business Home

ADDRESS PO Box 5877 Statesville

LOCATION 77S Tk Amity Hill TR Pilch TR Freda Ln Lot on (L)

SUBDIVISION Crater Valley BLOCK / SECTION LOT 4 LOT AREA SITE CLASS. D/S DESIGN FLOW 360 L.T.A.R. 0.3

Septic Tank: 1000 Gallons; STB 1012 Date 5-6-98

Pump Tank: Gallons; PT Date

Pump Make: Model Serial No.

Nitrification Field: No Fields 1 Square Feet 1700 Linear Feet 400

No Lines 4 Trench Width 36 Max Trench Bottom Depth 18-24

[X] New System [ ] Repair System Type: I (II) III, IV, V, VI

System Description: Gravity Conventional

Repair System Description: Pump Chamber/HDS Panel

Maintenance Agreement Required: [ ] Yes [ ] No

Gravel Depth 12in

[ ] House/Mod. Home [X] Mobile Home [ ] Business [ ] Other

No. Bedrooms 3 No. Bathrooms 2 No. Employees


[ ] Slab [X] Crawl Space [ ] Basement w/plumbing [ ] Basement wo/plumbing

Water Supply: [X] Individual [ ] Public [ ] Community


Comments:/Conditions: Keep lines on contour 9ft on center
No Deeper than 24in Trench Bottom

Comments:/Conditions: moved pipe hill
Note: Tank parall w/ windows - system moved up slightly

INITIAL SITE SKETCH

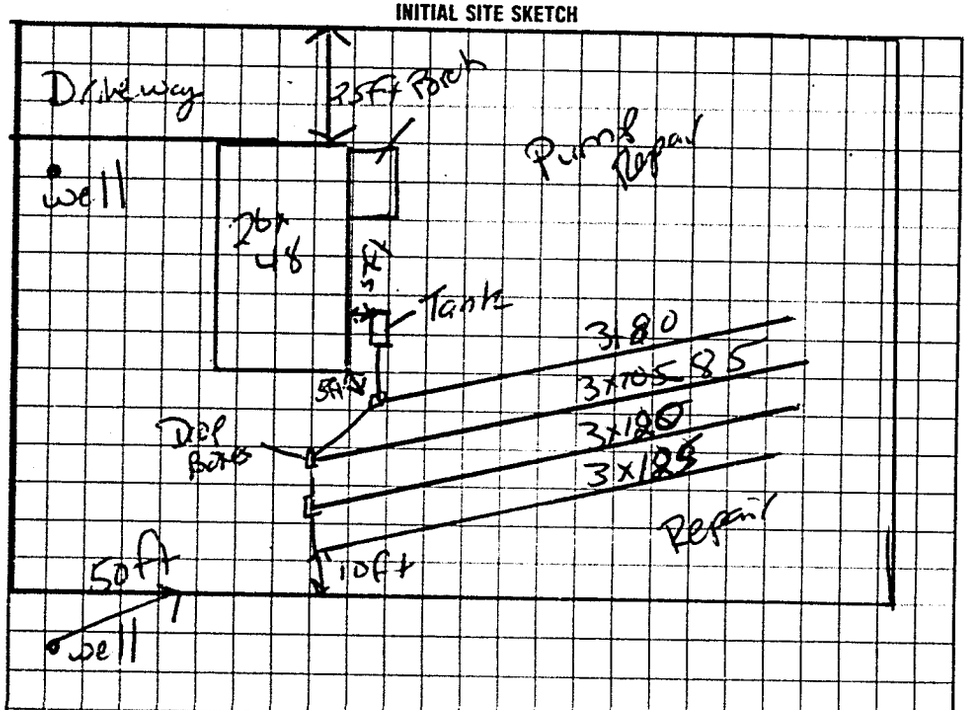

AS BUILT SKETCH

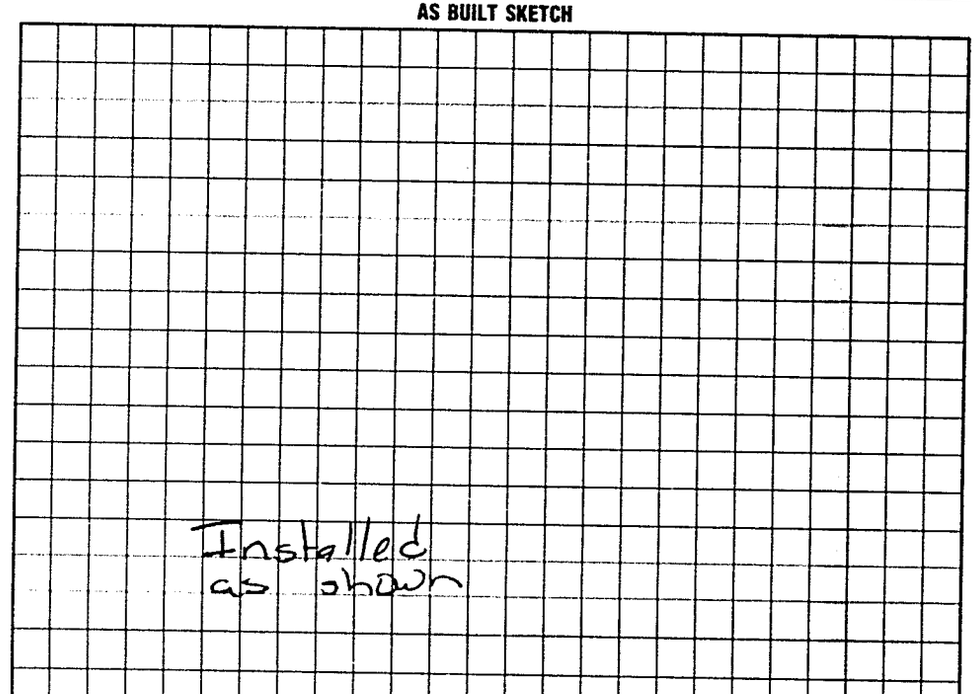

I understand that this permit can be suspended or revoked if any false information is supplied toward securing the permit/any unauthorized changes are made to the site/any unauthorized changes are made in the installation of the system. Improvement Permit with plat valid without expiration. Improvement Permit with site plan valid for sixty months. Authorization to Construct is valid for a period equal to that of Improvement Permit – not to exceed sixty months.

Signed: date 7/16/98

Improvement Permit by: Mark Cox RS date 6-17-98

Authorization to Construct by: Mark Cox RS date 6-17-98

Installed by: Tommy Frye

Operation Permit by: Mark Cox RS date 8-5-98

Existing System Inspection by: date

HEALTH DEPT COPY WHITE INSPECTION COPY (FINAL) GREEN OWNER COPY (FINAL) YELLOW INSPECTION COPY (INITIAL) PINK OWNER COPY (INITIAL) GOLD