IREDELL COUNTY HEALTH DEPARTMENT

STATESVILLE 704-878-5305 MOORESVILLE 704-664-5281

IMPROVEMENT PERMIT / AUTHORIZATION TO CONSTRUCT / OPERATION PERMIT / EXISTING SYSTEM INSPECTION

PERMIT# 069265 PIN# 4751484629(PT) DATE 1-15-98

OWNER OR CONTRACTOR Sunwood Builders PHONE: Business 872-0921 Home

ADDRESS PO Box 5877 Statesville

LOCATION I-77 S TL Amity Hill TR Pilch JR Freda Ln 1st on Rt

SUBDIVISION Crater Valley BLOCK / SECTION LOT 12 LOT AREA 0.52 SITE CLASS P/S DESIGN FLOW 360 L.T.A.R. 0.3

Septic Tank: 1000 Gallons; STB 1012 Date 1-7-98

Pump Tank: 1000 Gallons; PT 17 Date 6-9-98

Pump Make: Hydromate Model SK 50A1 Serial No. 5765480-1

Nitrification Field: No Fields 1 Square Feet 900 Linear Feet 300

No Lines 4 Trench Width 36in Max Trench Bottom Depth 36in Gravel Depth Sand

[X] New System [ ] Repair System Type: I, II, (III) IV, V, VI

System Description: Pump Chamber

Repair System Description: " " / Panel

Maintenance Agreement Required: [ ] Yes [X] No

[ ] House/Mod. Home [X] Mobile Home [ ] Business [ ] Other

No. Bedrooms 3 No. Bathrooms 2 No. Employees


[ ] Slab [X] Crawl Space [ ] Basement w/plumbing [ ] Basement wo/plumbing

Water Supply: [X] Individual [ ] Public [ ] Community


Comments:/Conditions: Keep lines on contour 9ft on center, see attachments for pump info. keep well 50ft from system Changed to 3@100ft

Comments:/Conditions: 6/4 Checked Tanks, Lines set Pressure Tanks set perpendicular to house near corner of house & Driveway

INITIAL SITE SKETCH

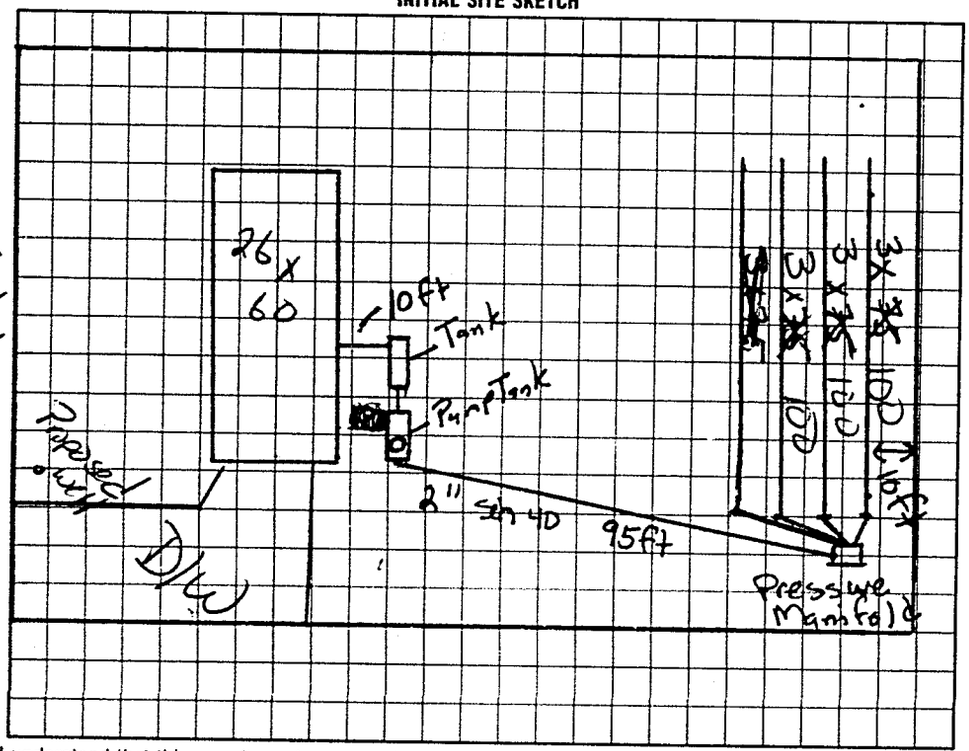

AS BUILT SKETCH

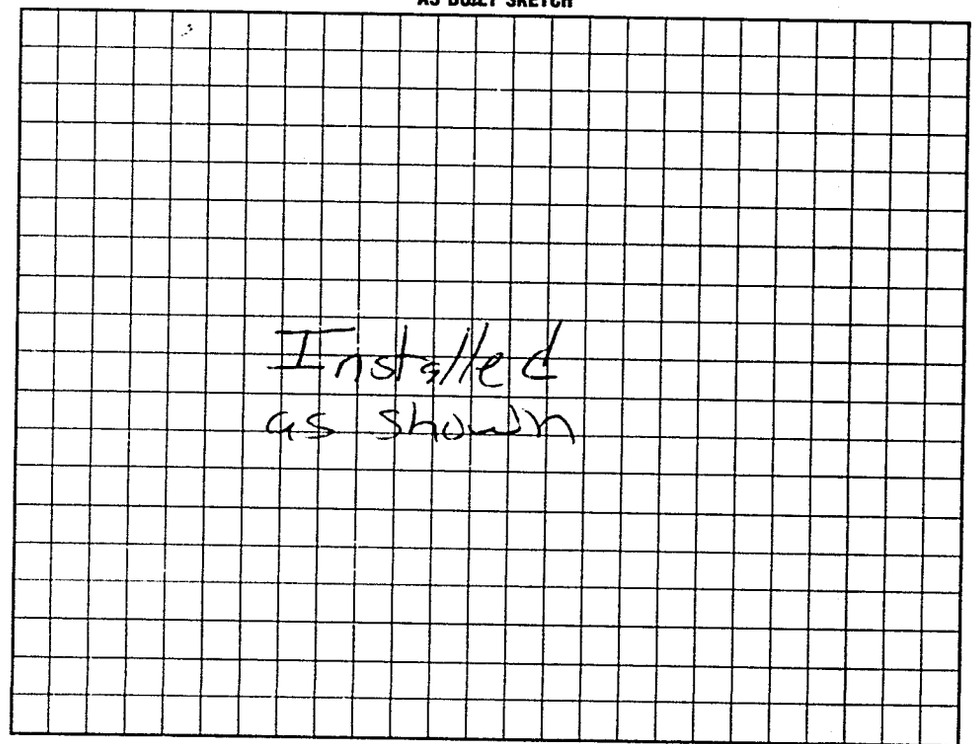

I understand that this permit can be suspended or revoked if any false information is supplied toward securing the permit/any unauthorized changes are made to the site/any unauthorized changes are made in the installation of the system. Improvement Permit with plat valid without expiration. Improvement Permit with site plan valid for sixty months. Authorization to Construct is valid for a period equal to that of Improvement Permit – not to exceed sixty months.

Signed: _____ date _____

Improvement Permit by: Mark Coty REHS date 1-15-98

Authorization to Construct by: Mark Coty REHS date 1-15-98

Installed by: A-1 Backhoe

Operation Permit by: Mark Coty REHS date 7-24-98

Existing System Inspection by: _____ date _____

HEALTH DEPT. COPY: WHITE INSPECTION COPY (FINAL): GREEN OWNER COPY (FINAL): YELLOW INSPECTION COPY (INITIAL): PINK OWNER COPY (INITIAL): GOLD

78100