IREDELL COUNTY HEALTH DEPARTMENT

STATESVILLE 704-878-5305 MOORESVILLE 704-664-5281

IMPROVEMENT PERMIT / CERTIFICATE OF COMPLETION / OPERATION PERMIT / EXISTING SYSTEM INSPECTION

PROPERTY DESCRIPTION NO. 069263 DATE 9-27-97 TAX MAP NO. 4751484629 Watershed: ☐ Yes ☒ No

OWNER OR CONTRACTOR Sunwood Builders PHONE: Business 872-0921 Home

ADDRESS PO Box 5877 Statesville

LOCATION 77S Exit 45 TL Amity Hill TR Pilch TR Fieldcrest 3 lots on left

SUBDIVISION Crabtree Valley BLOCK / SECTION LOT 3 LOT AREA 0.51 SITE CLASS. P/S DESIGN FLOW 360 L.T.A.R. 0.3

Septic Tank: 1000 Gallons; STB 1012 Date 3-16-98

Pump Tank: Gallons; PT Date

Pump Make: Model Serial No.

Nitrification Field: No Fields 1 Square Feet 1200 Linear Feet 400

No Lines 4 Trench Width 36in Max Trench Bottom Depth 36in Gravel Depth 12in

☒ New System ☐ Repair System Type: I, ☒ III, IV, V, VI

System Description: Gravity Conventional

Repair System Description: 1 Chamber

Maintenance Agreement Required: ☐ Yes ☒ No

☐ House/Mod. Home ☒ Mobile Home ☐ Business ☐ Other

No. Bedrooms 3 No. Bathrooms 2 No. Employees


☐ Slab ☒ Crawl Space ☐ Basement w/plumbing ☐ Basement wo/plumbing

Water Supply: ☒ Individual ☐ Community ☐ Public

Comments: Keep lines in contour 9ft on center
keep well max feasible dist 50ft min

Comments:
* Note Tank Turned

INITIAL SITE SKETCH

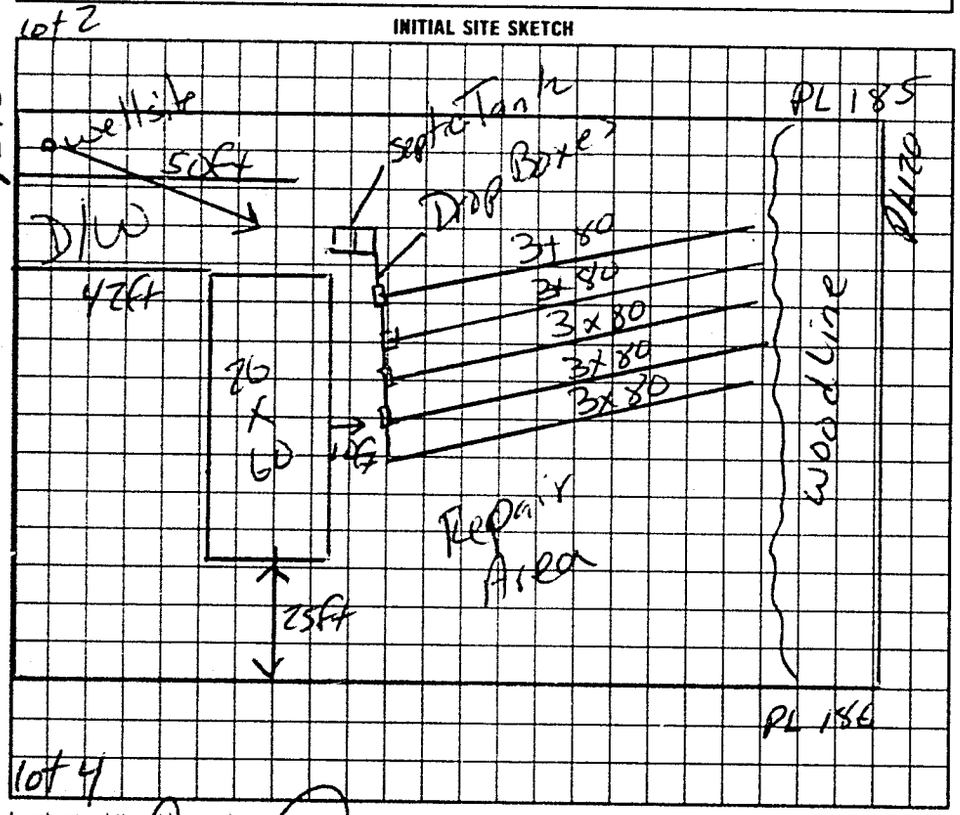

AS BUILT SKETCH

Installed as Shown

I understand that this permit can be suspended or revoked if any false information is supplied toward securing the permit/any unauthorized changes are made to the site/any unauthorized changes are made in the installation of the system. Improvement Permit is valid for 60 months from date of issuance.

Signed.

Improvement Permit by: Mark Craft RS date 9-27-97

Existing System Inspection by: Mark Craft RS date 9-27-97

Installed by: Tommy Frye

Certificate of Completion by: date

Operation Permit by: Mark Craft RS date 6-3-98

HEALTH DEPT. COPY: WHITE INSPECTION COPY (FINAL): GREEN OWNER COPY (FINAL): YELLOW INSPECTION COPY (INITIAL): PINK OWNER COPY (INITIAL): GOLD