IREDELL COUNTY HEALTH DEPARTMENT

STATESVILLE 704-878-5305 MOORESVILLE 704-664-5281

IMPROVEMENT PERMIT / CERTIFICATE OF COMPLETION / OPERATION PERMIT / EXISTING SYSTEM INSPECTION

PROPERTY DESCRIPTION NO. 069266 DATE 9-27-97 TAX MAP NO. 4754846291 PT Watershed: ☐ Yes ☒ No

OWNER OR CONTRACTOR Sunwood Builders PHONE: Business 872 0921 Home

ADDRESS PO Box 5877 Statesville NC

LOCATION 775 Ex 145 TL Amity Hill TR Pioh TR Freda Ln 3 lot on Rt

SUBDIVISION Crater Valley BLOCK / SECTION LOT 13 LOT AREA 0.52ac SITE CLASS. P/S DESIGN FLOW 360 L.T.A.R. 0.3

Septic Tank: 1000 Gallons; STB 1012 Date 3-16-98

Pump Tank: Gallons; PT Date

Pump Make: Model Serial No.

Nitrification Field: No Fields 1 Square Feet 1200 Linear Feet 400

No Lines 4 Trench Width 36in Max Trench Bottom Depth 36in Gravel Depth 12in

☒ New System ☐ Repair System Type: I, ☐ II, III, IV, V, VI

System Description: Crawl Conventional

Repair System Description: Crawl Conventional

Maintenance Agreement Required: ☐ Yes ☒ No

☐ House/Mod. Home ☒ Mobile Home ☐ Business ☐ Other

No. Bedrooms 3 No. Bathrooms 2 No. Employees


☐ Slab ☒ Crawl Space ☐ Basement w/plumbing ☐ Basement wo/plumbing

Water Supply: ☒ Individual ☐ Community ☐ Public


Comments: keep lines on contour 9ft on center keep well max feasible distance min 50 ft.

Comments:

INITIAL SITE SKETCH

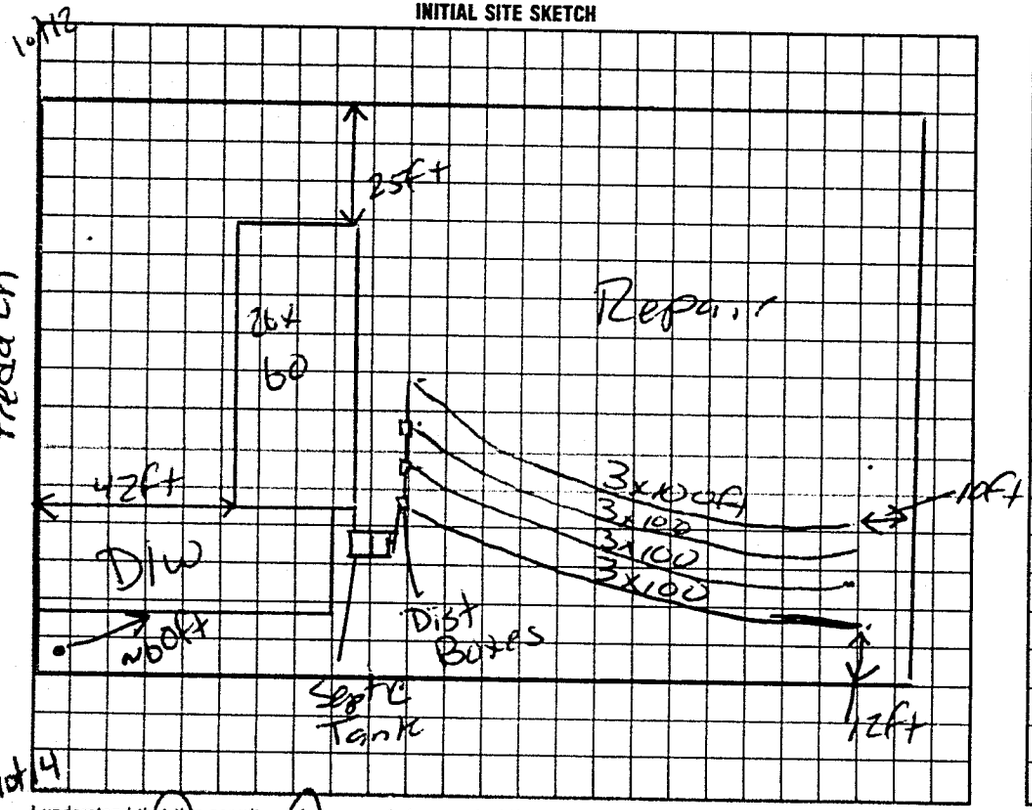

AS BUILT SKETCH

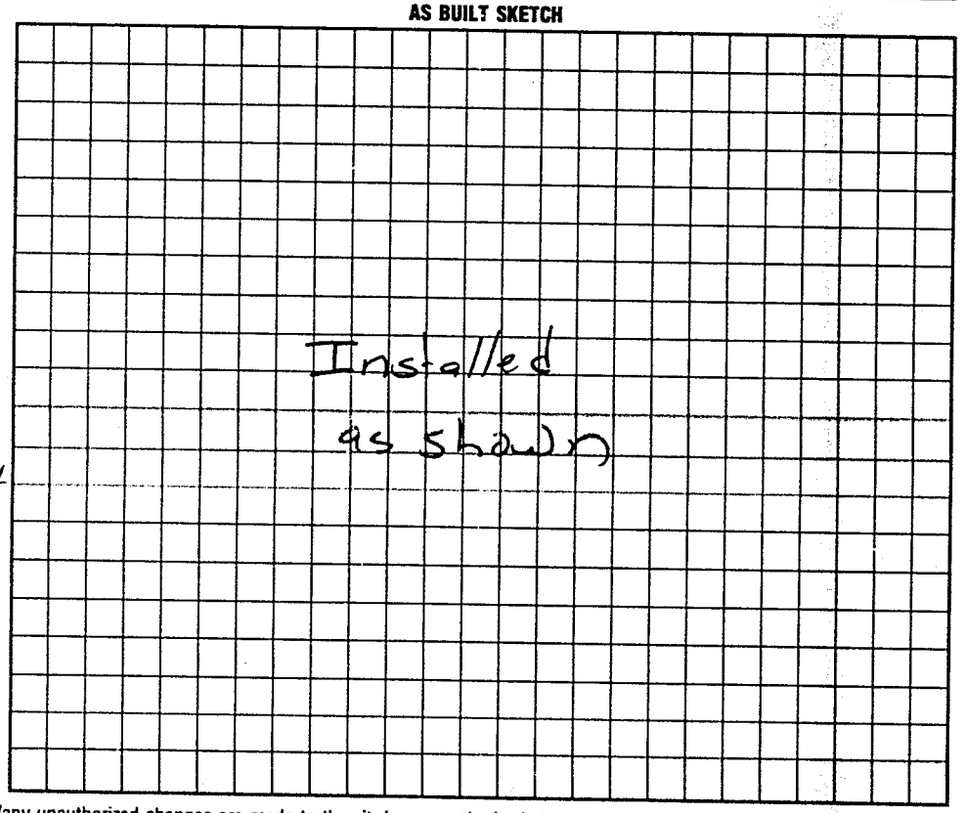

I understand that this permit can be suspended or revoked if any false information is supplied toward securing the permit/any unauthorized changes are made to the site/any unauthorized changes are made in the installation of the system. Improvement Permit is valid for 60 months from date of issuance

Signed:

Improvement Permit by: Mark C Oates date 9-27-97

~~Existing System Inspection~~ by: Mark C Oates date 9-27-97

Installed by: Tommy Frye

Certificate of Completion by: date

Operation Permit by: Mark C Oates date 6-3-98

HEALTH DEPT COPY WHITE INSPECTION COPY (FINAL) GREEN OWNER COPY (FINAL) YELLOW INSPECTION COPY (INITIAL) PINK OWNER COPY (INITIAL) GOLD