IREDELL COUNTY HEALTH DEPARTMENT

STATESVILLE 704-878-5305 MOORESVILLE 704-664-5281

IMPROVEMENT PERMIT / CERTIFICATE OF COMPLETION / OPERATION PERMIT / EXISTING SYSTEM INSPECTION

PROPERTY DESCRIPTION NO. 069262 DATE 9-27-97 TAX MAP NO. 4751418629 PT

OWNER OR CONTRACTOR Sherwood Builders PHONE: Business 872-0921 Home

ADDRESS PO Box 5877 Statesville NC Watershed: ☐ Yes ☒ No

LOCATION 773 East 45 TL Amity Hill TR Pinch Rd TR Freda Ln 2nd Lot on Left

SUBDIVISION Crater Valley BLOCK / SECTION LOT 2 LOT AREA 0.51 SITE CLASS. D/S DESIGN FLOW 360 L.T.A.R. 0.3

Septic Tank: 1000 Gallons; STB 1012 Date 8-26-97

Pump Tank: Gallons; PT Date

Pump Make: Model Serial No.

Nitrification Field: No Fields 1 Square Feet 1700 Linear Feet 400

No Lines 4 Trench Width 36in Max Trench Bottom Depth 36in Gravel Depth 12in

☒ New System ☐ Repair System Type: I, II, III, IV, V, VI

System Description: Graver Conventional

Repair System Description: Graver Chamber

Maintenance Agreement Required: ☐ Yes ☒ No

☐ House/Mod. Home ☒ Mobile Home ☐ Business ☐ Other

No. Bedrooms 3 No. Bathrooms 2 No. Employees


☐ Slab ☒ Crawl Space ☐ Basement w/plumbing ☐ Basement wo/plumbing

Water Supply: ☒ Individual ☐ Community ☐ Public


Comments: Keep lines on contour 9ft on center keep well max feasible dist 50ft min.

Comments:

INITIAL SITE SKETCH

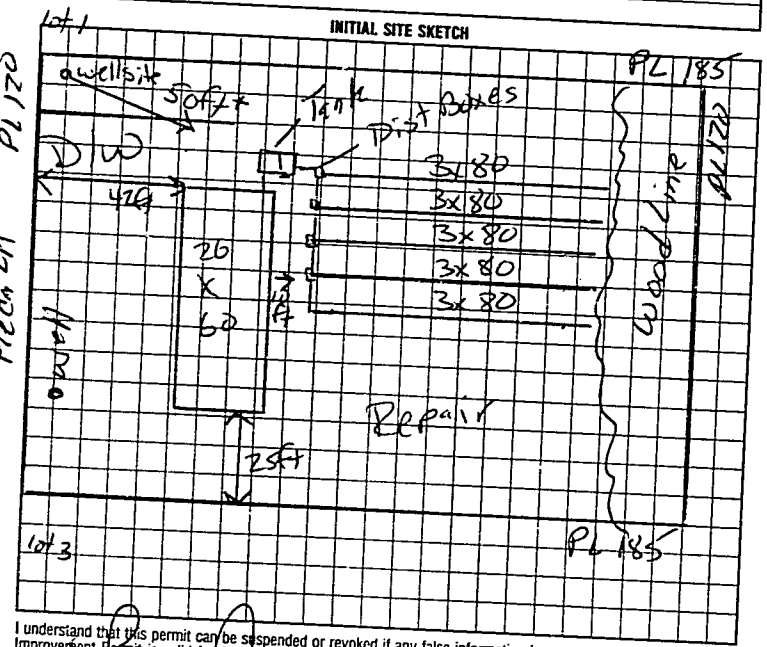

AS BUILT SKETCH

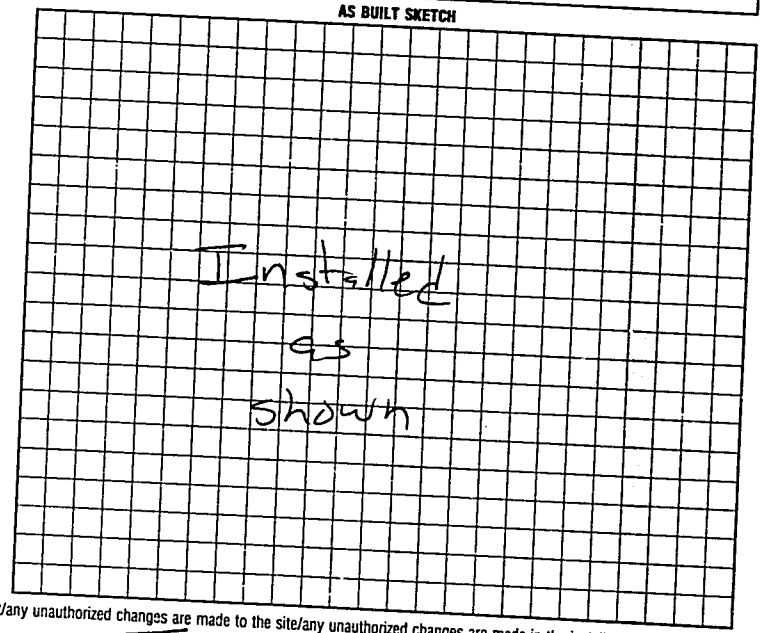

I understand that this permit can be suspended or revoked if any false information is supplied toward securing the permit/any unauthorized changes are made to the site/any unauthorized changes are made in the installation of the system. Improvement Permit is valid for 60 months from date of issuance.

Signed:

Improvement Permit by: Mark Cox RS date 9-27-97

Authorization to Construct by: Mark Cox RS date 9-27-97

Existing System Inspection by:

Installed by: Tommy Frye

Certificate of Completion by: date

Operation Permit by: Mark Cox RS date 11-24-97

HEALTH DEPT. COPY: WHITE INSPECTION COPY (FINAL): GREEN OWNER COPY (FINAL): YELLOW INSPECTION COPY (INITIAL): PINK OWNER COPY (INITIAL): BLUE