CT

IREDELL COUNTY HEALTH DEPARTMENT

STATESVILLE 704-878-5305 MOORESVILLE 704-664-5281

IMPROVEMENT PERMIT / AUTHORIZATION TO CONSTRUCT / OPERATION PERMIT / EXISTING SYSTEM INSPECTION

PERMIT# 140819 PIN# 4751-48-6764 DATE 3-5-07

OWNER OR APPLICANT RONNIE SHEETS PHONE: Business 704-876-1111 Home 704-872-6613

ADDRESS 112 FREDA LANE, STATESVILLE NC 28677

LOCATION I-77 S, TL AMITY HILL ROAD, TR PILCH ROAD, TR FREDA LANE 2ND HOUSE ON RIGHT

SUBDIVISION CRATER VALLEY BLOCK / SECTION 1 LOT 14 LOT AREA 0.52 ACRE SITE CLASS. PS DESIGN FLOW 480 L.T.A.R. 0.20 GPD/FT

Septic Tank: EXISTING Gallons: STB Date

Pump Tank: Gallons: PT Date

Pump Make: Model Serial No.

Nitrification Field: No Fields 1 Square Feet EQUIV 640 Linear Feet 160

No Lines TWO Trench Width 36" Max Trench Bottom Depth 36" Gravel Depth N/A

☐ New System ☐ Repair ☑ Expansion System Type: I II III IV V VI

System Description: 25% REDUCTION GRAVITY

Repair System Description: 50% REDUCTION GRAVITY LOW PRESSURE

Maintenance Agreement Required: ☐ Yes ☑ No

☑ House/Mod. Home ☐ Mobile Home ☐ Business ☐ Other

No. Bedrooms 4 No. Persons No. Employees


Water Supply: ☑ Individual ☐ Public ☐ Community WELL

☑ Gravity ☐ Pressure ☐ Slab ☑ Crawl Space ☐ Basement w/plumbing ☐ Basement wo/plumbing


Comments:/Conditions: ① EXPAND EXISTING SYSTEM AS SHOWN ON CONTOUR, USING THREE NEW DROP BOXES FOR SERIAL DISTRIBUTION. ② KEEP SYSTEM MINIMUM 5' FROM HOUSE

Comments:/Conditions: Put T-Flow Divider at Last Line to The Systems Together

INITIAL SITE SKETCH N 1"=40'

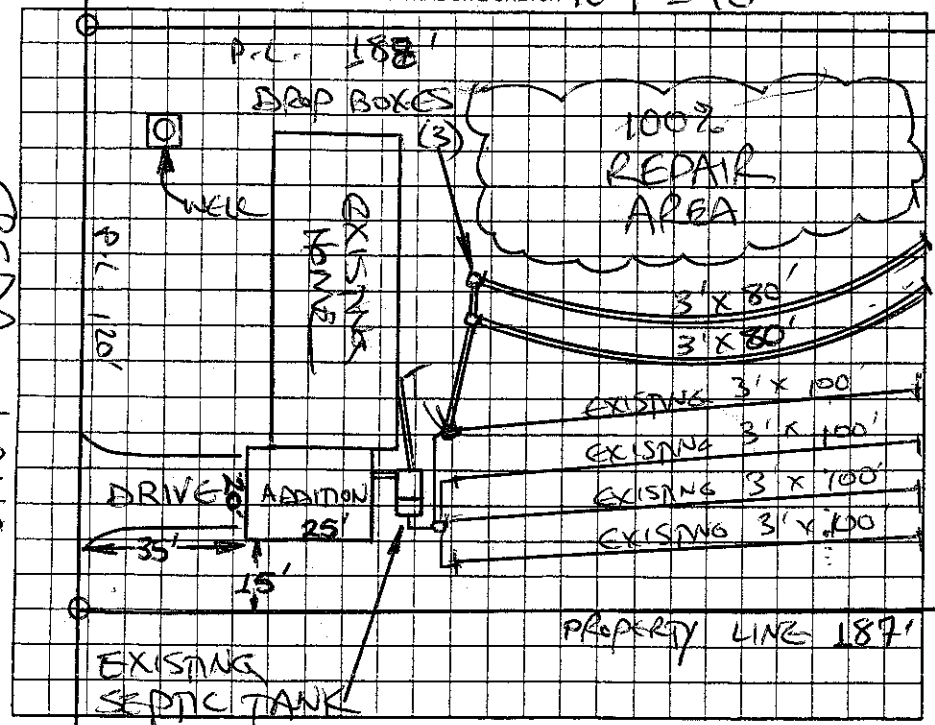

AS BUILT SKETCH

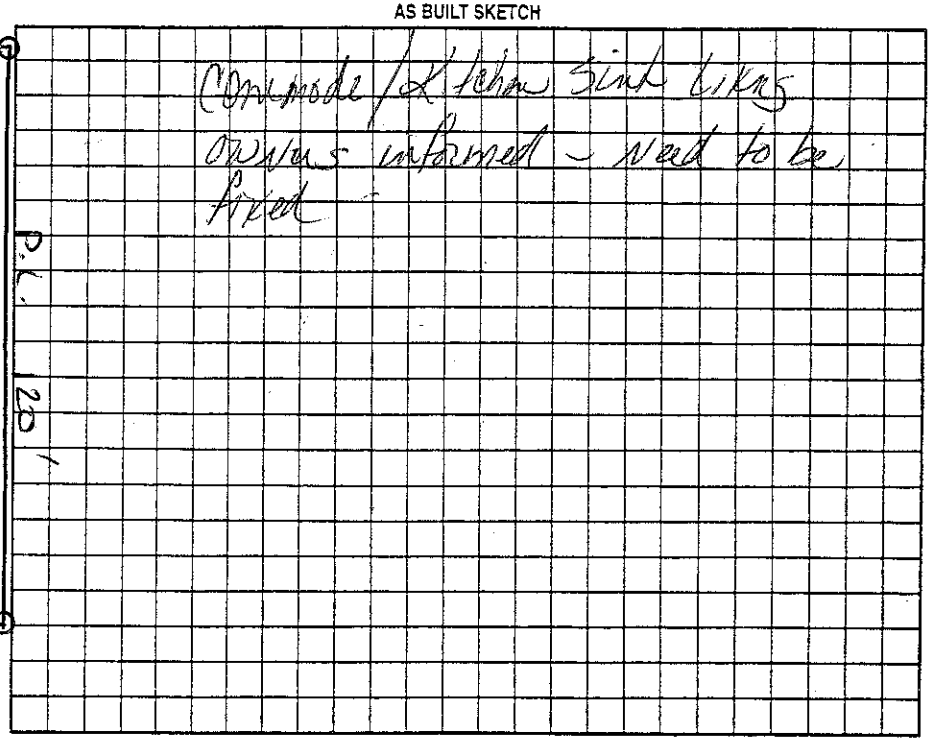

Permit can be suspended or revoked if any false information is supplied toward securing the permit/any unauthorized changes are made to the site/any unauthorized changes are made in the installation of the system. Improvement Permit with plat valid without expiration ☐ Improvement Permit with site plan valid for sixty months ☑ Authorization to Construct is valid for a period equal to that of Improvement Permit – not to exceed sixty months.

Signed +Ronnie D Sheets date 3-5-07 Installed by: ESKER ELDER

Improvement Permit by: STEVE HENDRICK date 3-5-07 Operation Permit by: Kelly Cox date 3 MAY 07

Authorization to Construct by: STEVE HENDRICK date 3-5-07 Existing System Inspection by: date

HEALTH DEPT. COPY: WHITE OWNER COPY (FINAL): YELLOW OWNER COPY (INITIAL): PINK