IREDELL COUNTY HEALTH DEPARTMENT

STATESVILLE 704-878-5305 MOORESVILLE 704-664-5281

IMPROVEMENT PERMIT / CERTIFICATE OF COMPLETION / OPERATION PERMIT / EXISTING SYSTEM INSPECTION

PROPERTY DESCRIPTION NO. 069261 DATE 9-27-97 TAX MAP NO. 4751-18-4629 PT Watershed: ☐ Yes ☒ No

OWNER OR CONTRACTOR SunWood Builders PHONE: Business 872-0921 Home

ADDRESS POBox 5877 Statesville NC

LOCATION 77S Exit 45 TL Amity Hill TR Pitch TR Fredn Ln 1st lot on Left

SUBDIVISION CraterValley BLOCK/SECTION LOT LOT AREA .63 SITE CLASS. P/S DESIGN FLOW 360 L.T.A.R. 0.3

Septic Tank: 1000 Gallons; STB 1012 Date

Pump Tank: Gallons; PT Date

Pump Make: Model Serial No.

Nitrification Field: No Fields 1 Square Feet 1200 Linear Feet 400

No Lines 4 Trench Width 36in Max Trench Bottom Depth 36in Gravel Depth 12in

☒ New System ☐ Repair System Type: I, II, III, IV, V, VI

System Description: Gravity Conventional

Repair System Description: Pump Chamber/Pump

Maintenance Agreement Required: ☐ Yes ☒ No

☐ House/Mod. Home No. Bedrooms 3

☒ Mobile Home No. Bathrooms 2

☐ Business No. Employees

☐ Other


☐ Slab ☒ Crawl Space ☐ Basement w/plumbing ☐ Basement wo/plumbing

Water Supply: ☒ Individual ☐ Community ☐ Public


Comments: keep lines on contour 9ft on center keep out of all max tessable distance 50ft min.

Comments:

INITIAL SITE SKETCH

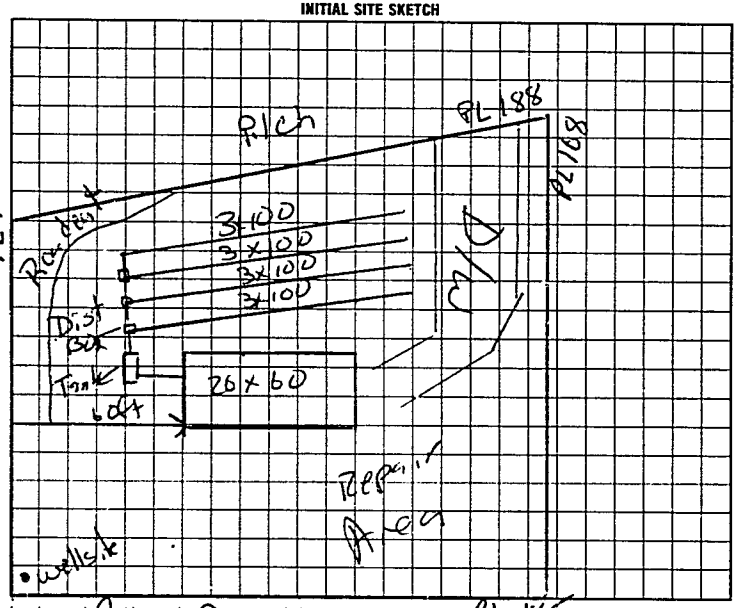

AS BUILT SKETCH

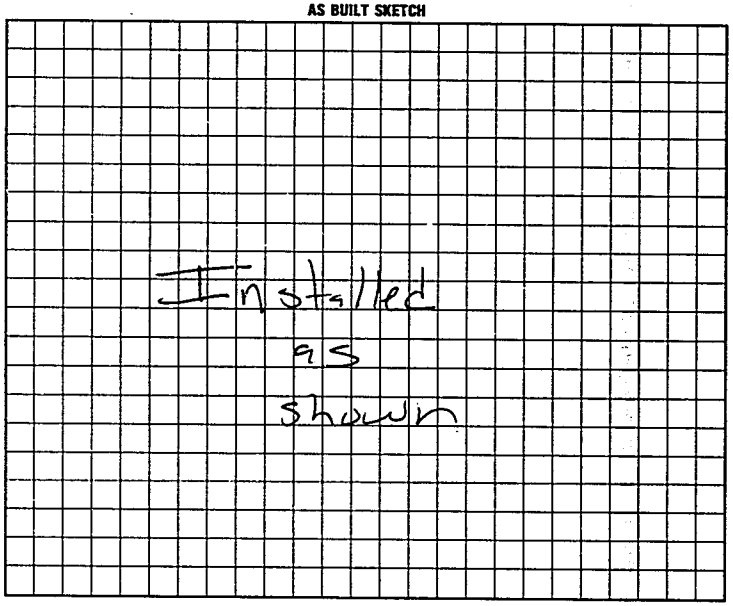

I understand that this permit can be suspended or revoked if any false information is supplied toward securing the permit/any unauthorized changes are made to the site/any unauthorized changes are made in the installation of the system. Improvement Permit is valid for 60 months from date of issuance.

Signed:

Improvement Permit by: Mary C Ort RS date 9-27-97

Existing System Inspection by: Mary C Ort RS date 9-27-97

Installed by: Tommy Frye

Certificate of Completion by: date

Operation Permit by: Mary C Ort RS date 11-24-97

Authorization

COPY - HEALTH DEPT. COPY WHITE INSPECTION COPY (FINAL) GREEN OWNER COPY (FINAL) YELLOW INSPECTION COPY (INITIAL) PINK OWNER COPY (INITIAL) GOLD

0028333